IREDELL COUNTY HEALTH DEPARTMENT

Statesville Phone TR 3-7271 Mooresville Phone NO 3-1271

PERMIT TO INSTALL SEPTIC TANK

Permit No. 212 Permit Date Oct. 8 1970

Owner Regency Lake Address Mooresville NC.

Installed By Wilson Septic Tank Service Address Shelby, NC.

Location of Property


LOT 4 - BLOCK B

Tank		Capacity		Length of Lines		Fixtures	
Block	( )	1000	( )	225'	( )	No. of Baths	( )
Precast	( )	1250	( )	250'	( )	Dishwasher	( )
		1500	( )	Other		Garbage Grdr.	( )
		Other				Other	

NOTIFY HEALTH DEPARTMENT AT LEAST EIGHT HOURS BEFORE TANK IS TO BE INSPECTED.

Final Inspection Oct. 8 1970 Approved (✓) Disapproved ( )

Remarks

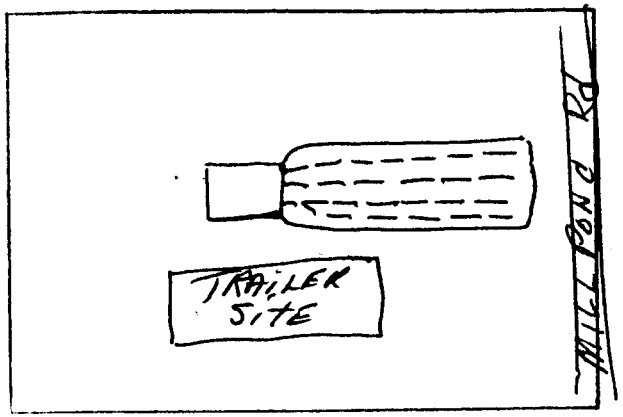

Sketch of Installation

Sanitarian