4646-08-4278

IREDELL COUNTY HEALTH DEPARTMENT

STATESVILLE 704-878-5305 MOORESVILLE 704-664-5281

IMPROVEMENT PERMIT / CERTIFICATE OF COMPLETION / OPERATION PERMIT / EXISTING SYSTEM INSPECTION

PROPERTY DESCRIPTION NO. 20078 DATE March 6, '95 TAX MAP NO. 2K 14B1 Watershed: ☑ Yes ☐ No

OWNER OR CONTRACTOR Bill Wodledge PHONE: Business _____ Home _____ WSIV

ADDRESS RT 7, Box 681, Mooresville

LOCATION 1100 Th CANVASback Tr Regency Blvd TR Hazelton on Right

SUBDIVISION Regency Lake BLOCK / SECTION B LOT 1 LOT AREA 105'x170' SITE CLASS. PS DESIGN FLOW 240 gpd L.T.A.R. .3

Septic Tank: 1000 Gallons; STB 734 Dplinger Date 7-18-95

Pump Tank: _____ Gallons; PT _____ Date _____

Pump Make: _____ Model _____ Serial No. 209 ~~266~~

Nitrification Field: No Fields 1 Square Feet 800 Linear Feet ~~266~~

No Lines 4 Trench Width 36" Max Trench Bottom Depth (18") Gravel Depth 12"

☑ New System ☐ Repair System Type: I, (II), III, IV, V, VI.

System Description: Shallow gravity ~~conventional~~

Repair System Description: Same INSPECTION

Maintenance Agreement Required: ☐ Yes ☑ No

☐ House/Mod. Home ☑ Mobile Home ☑ Business ☐ Other

No. Bedrooms 2 No. Bathrooms 1½ No. Employees ____

☐ Slab ☑ Crawl Space ☐ Basement w/plumbing ☐ Basement wo/plumbing


Water Supply: ☐ Individual ☑ Community ☐ Public

Comments: Keep trenches shallow due to lots of hard weathered rock.

Comments: Notes Tank Location Boring #1 - will have to set with ~30 days KR-PRK

1"=50'

INITIAL SITE SKETCH

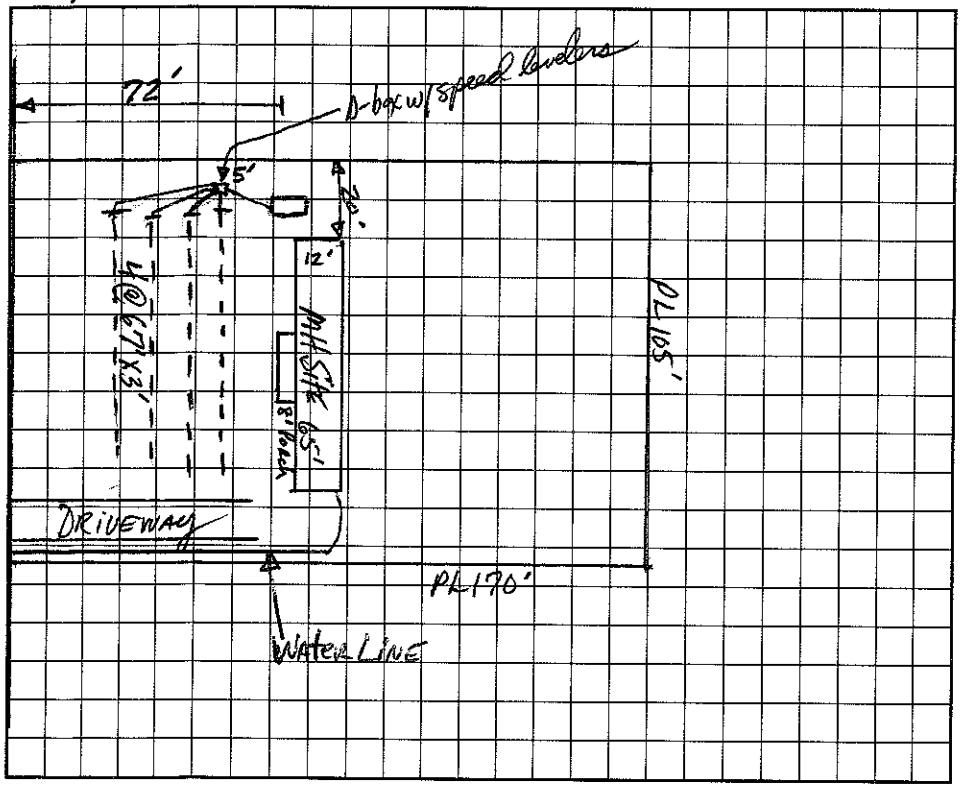

AS BUILT SKETCH

I understand that this permit can be suspended or revoked if any false information is supplied toward securing the permit/any unauthorized changes are made to the site/any unauthorized changes are made in the installation of the system. Improvement Permit is valid for 60 months from date of issuance.

Signed: _____

Improvement Permit by: _____ date 3/6/95

Existing System Inspection by: _____ date _____

Installed by: Ken Painter

Certificate of Completion by: _____ date _____

Operation Permit by: _____ date 9-13-95

HEALTH DEPT. COPY: WHITE INSPECTION COPY (FINAL): GREEN OWNER COPY (FINAL): YELLOW INSPECTION COPY (INITIAL): PINK OWNER COPY (INITIAL): GOLD