Paid 125.00

IREDELL COUNTY HEALTH DEPARTMENT

STATESVILLE 704-878-5305 MOORESVILLE 704-664-5281

IMPROVEMENT PERMIT / AUTHORIZATION TO CONSTRUCT / OPERATION PERMIT / EXISTING SYSTEM INSPECTION

PERMIT# 093315 PIN# 4646084771 DATE 12/19/2000

OWNER OR CONTRACTOR Christine Parker/Fleetwood Homes PHONE: Business (704) 982-5555 Home

ADDRESS Lane St. Kannapolis, NC 28081

LOCATION Brawley School Rd Canvasback Tr Regency Dr 2nd Rd Tr 1st Rd (Shalmar)

SUBDIVISION Regency Lake BLOCK / SECTION C LOT 10 LOT AREA .5 Acre SITE CLASS. PS DESIGN FLOW 360gpd L.T.A.R. .3-.25

Septic Tank: 1000 Gallons; STB 312 Date 9-3-2000

Pump Tank: ____ Gallons; PT ____ Date ____

Pump Make: ____ Model ____ Serial No. ____

Nitrification Field: No Fields 1 Square Feet 900' Linear Feet 360'

No Lines 6 at 50' Trench Width 36" Max Trench Bottom Depth 24" Gravel Depth N/A

X New System ☐ Repair System Type: I, II, III, IV, V, VI

System Description: Gravity-25% Reduction

Repair System Description: Pump-Panel Blk

Maintenance Agreement Required: ☐ Yes X No

☐ House/Mod. Home No. Bedrooms 3

X Mobile Home No. Bathrooms 2

☐ Business No. Employees ____

☐ Other ____

☐ Slab X Crawl Space ☐ Basement w/plumbing ☐ Basement wo/plumbing


Water Supply: ☐ Individual X Public X Community

Comments:/Conditions: Keep Septic System at least 10' From PL & 5' From House.


* Note: Lot thick when evaluated may need to alter Septic Drainfield when cleared.

Comments:/Conditions: Polylok filter installed 2/20/2001 Checked tank & lines. Need to install ~ 72' more of Drainline ~~Need~~

INITIAL SITE SKETCH Scale 1:50

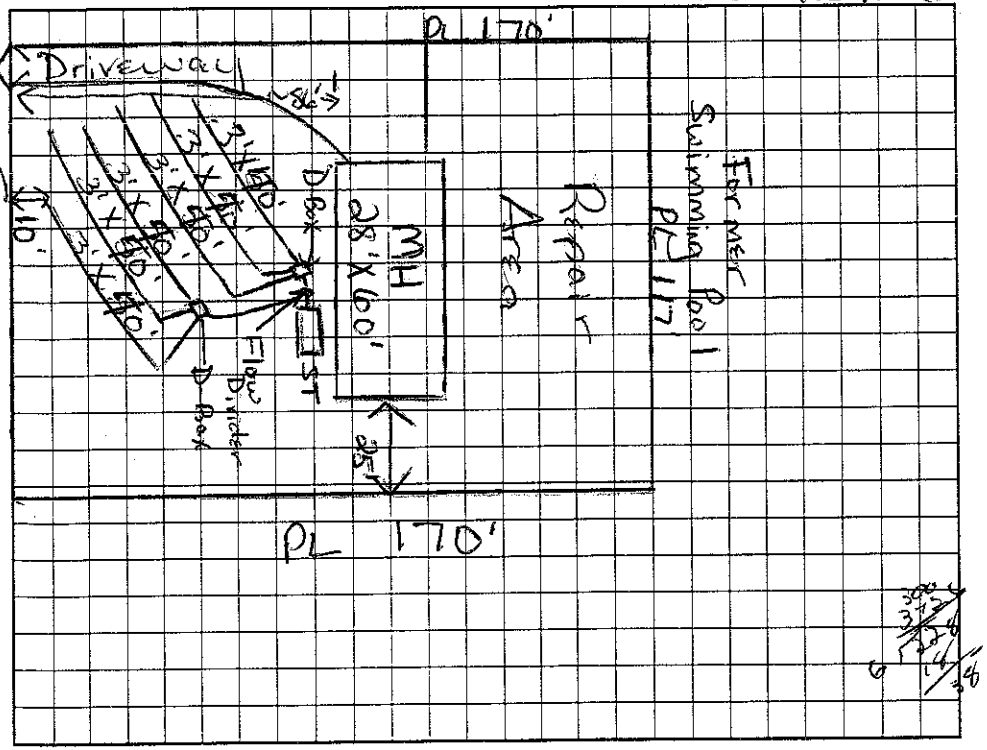

AS BUILT SKETCH

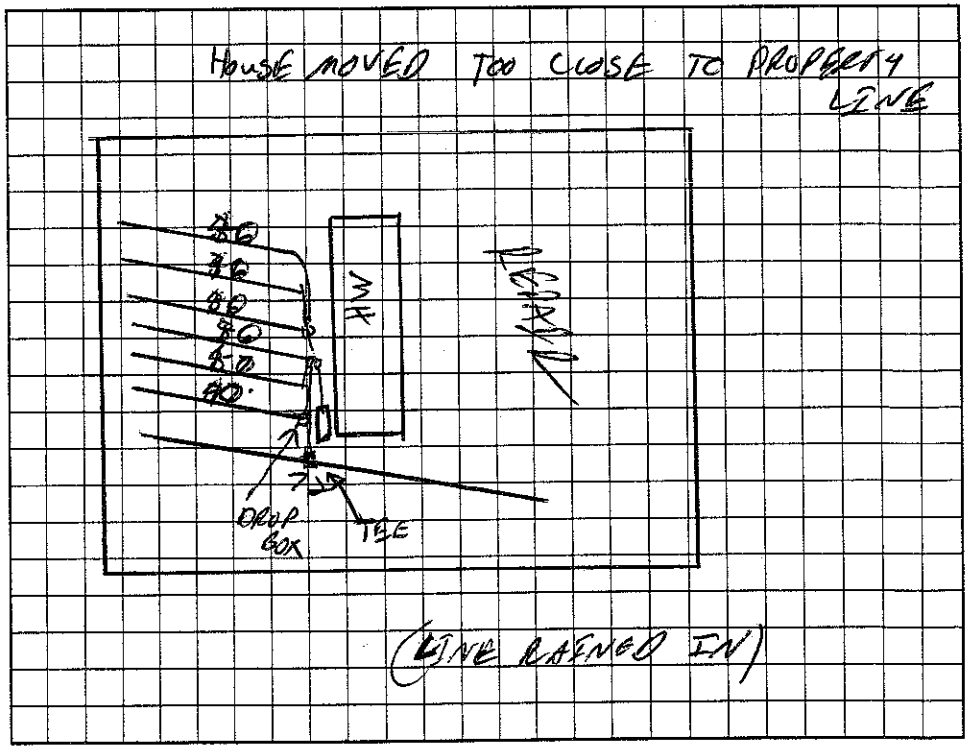

Permit can be suspended or revoked if any false information is supplied toward securing the permit/any unauthorized changes are made to the site/any unauthorized changes are made in the installation of the system. Improvement Permit with plat valid without expiration. Improvement Permit with site plan valid for sixty months. Authorization to Construct is valid for a period equal to that of Improvement Permit – not to exceed sixty months.

Signed: [signature] date 12-28-00 Installed by: Bob's Backhoe

Improvement Permit by: Marie H. H. Dotson R.S. date 12/19/2000 Operation Permit by: C. Ag RS date 2/27/01

Authorization to Construct by: Marie H. H. Dotson RS date 12/19/2000 Existing System Inspection by: ____ date ____

HEALTH DEPT. COPY: WHITE OWNER COPY (FINAL): YELLOW OWNER COPY (INITIAL): PINK