IREDELL COUNTY HEALTH DEPARTMENT

STATESVILLE 704-878-5305 MOORESVILLE 704-664-5281

4:00

IMPROVEMENT PERMIT / AUTHORIZATION TO CONSTRUCT / OPERATION PERMIT / EXISTING SYSTEM INSPECTION

PERMIT# 090693 PIN# 4646 08 6249 DATE 7/31/00

OWNER OR CONTRACTOR Easyway Inc. PHONE: Business 704-664-7727 Home

ADDRESS PO Box 3303 Mooresville, NC. 28117

LOCATION 1100 TL Canvasback TL Regency R Hazelton on (R)

SUBDIVISION Regency Lake BLOCK / SECTION B LOT 10 LOT AREA ~17000 FT² SITE CLASS. 135 DESIGN FLOW 360 L.T.A.R. .35

Septic Tank: 1600 Gallons; STB 1012 Date 5-8-00
Pump Tank: Gallons; PT Date
Pump Make: Model Serial No.
Nitrification Field: No Fields 1 Square Feet 1026 Linear Feet 342
No Lines 5@70' Trench Width 36" Max Trench Bottom Depth 36" Gravel Depth 12"

☒ New System ☐ Repair System Type: I, (II), III, IV, V, VI
System Description: Gravity-Conventional
Repair System Description: 16" PPBS
Maintenance Agreement Required: ☐ Yes ☒ No


☒ House/Mod. Home No. Bedrooms 3
☐ Mobile Home No. Bathrooms 3
☐ Business No. Employees
☐ Other
☐ Slab ☒ Crawl Space ☐ Basement w/plumbing ☐ Basement wo/plumbing

Water Supply:
☐ Individual
☐ Public
☒ Community

Comments:/Conditions:

Comments:/Conditions: Installed as Drawn

INITIAL SITE SKETCH

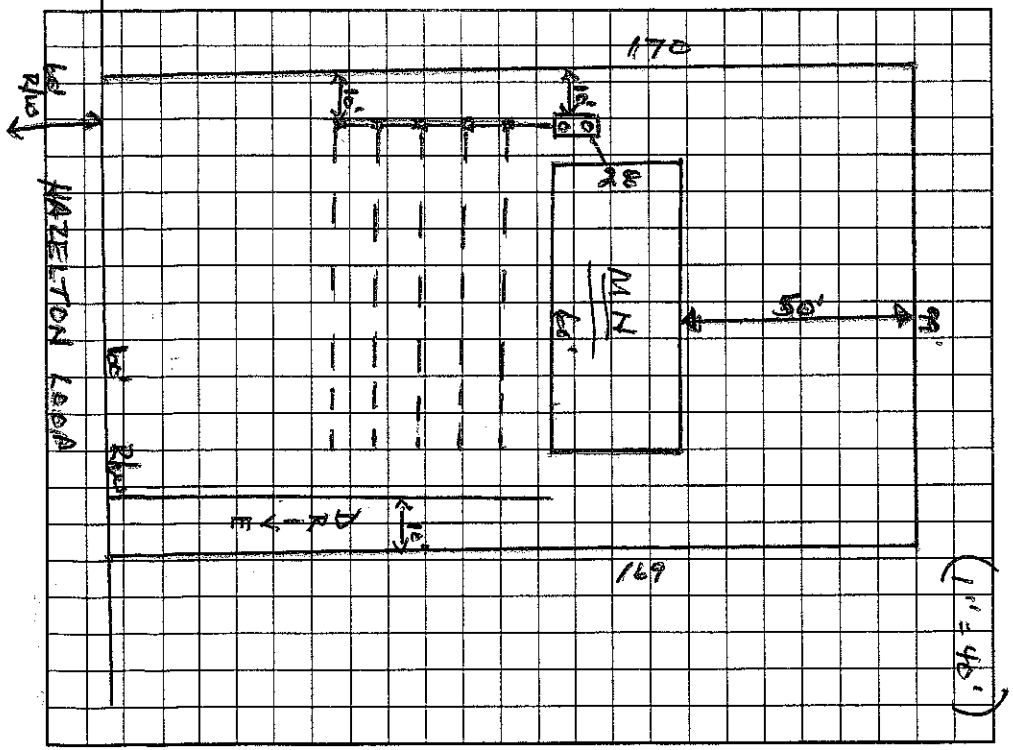

AS BUILT SKETCH

Permit can be suspended or revoked if any false information is supplied toward securing the permit/any unauthorized changes are made to the site/any unauthorized changes are made in the installation of the system. Improvement Permit with plat valid without expiration. Improvement Permit with site plan valid for sixty months. Authorization to Construct is valid for a period equal to that of Improvement Permit – not to exceed sixty months.

Signed: [signature] date 7-31-00

Improvement Permit by: Wesley Sparks RS. date 7/31/00

Authorization to Construct by: Wesley Sparks RS. date 7/31/00

Installed by: A-1 Backhoe

Operation Permit by: Marcus H. Dotson RS date 8/9/2000

Existing System Inspection by: date

HEALTH DEPT. COPY: WHITE OWNER COPY (FINAL): YELLOW OWNER COPY (INITIAL): PINK