IREDELL COUNTY HEALTH DEPARTMENT

Statesville Phone TR 3-7271 Mooresville Phone NO 3-1271

PERMIT TO INSTALL SEPTIC TANK

Permit No. 211 Permit Date Oct 8 1970

Owner Regency Lake Address Mooresville, N.C.

Installed By Thomas Septic Tank Service Address Shelby, N.C.

Location of Property Regency Lake


Lot 4 - Block C

Tank		Capacity		Length of Lines		Fixtures	
Block	( )	1000	( )	225'	( )	No. of Baths	( )
Precast	( )	1250	( )	250'	( )	Dishwasher	( )
		1500	( )	Other		Garbage Grdr.	( )
		Other				Other	

NOTIFY HEALTH DEPARTMENT AT LEAST EIGHT HOURS BEFORE TANK IS TO BE INSPECTED.

Final Inspection Oct 8 1970 Approved (✓) Disapproved ( )

Remarks

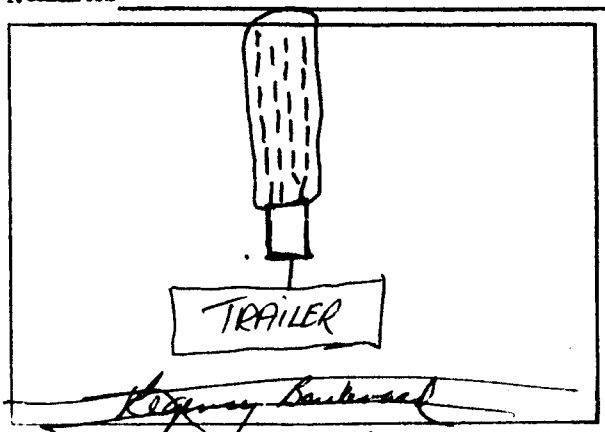

Sketch of Installation

Sanitarian