# IREDELL COUNTY HEALTH DEPARTMENT

STATESVILLE 704-878-5305 MOORESVILLE 704-664-5281

## IMPROVEMENT PERMIT / AUTHORIZATION TO CONSTRUCT / OPERATION PERMIT / EXISTING SYSTEM INSPECTION

125.00 Paid 1/30

PERMIT# 094254 PIN# 4646 08 6817 DATE 2/12/01

OWNER OR CONTRACTOR Easyway Inc. PHONE: Business 664-7727 Home

ADDRESS PO Box 3303 Mooresville, NC. 28117

LOCATION Brawley Sch (L) Cemetery Lake (L) Regency on (R) just past Well Lots.

SUBDIVISION Regency Lake BLOCK / SECTION C LOT 4 LOT AREA .37Ac SITE CLASS. PS DESIGN FLOW 360 L.T.A.R. .3

Septic Tank: 1000 Gallons; STB 1012 Date 10-20-00
Pump Tank: Gallons; PT Date
Pump Make: Model Serial No.
Nitrification Field: No Fields 1 Square Feet 900* Linear Feet 300*
No Lines 4@75'* Trench Width 3' Max Trench Bottom Depth 3' Gravel Depth No

[X] New System [ ] Repair System Type: I, II, (III) IV, V, VI
System Description: *GRAV - CH. PLAS OR EZ Flow
Repair System Description: * SAME
Maintenance Agreement Required: [ ] Yes [ ] No


[X] House/Mod. Home No. Bedrooms 3
[ ] Mobile Home No. Bathrooms 3
[ ] Business No. Employees
[ ] Other
[ ] Slab [X] Crawl Space [ ] Basement w/plumbing [ ] Basement wo/plumbing

Water Supply: [ ] Individual [ ] Public [X] Community


Comments:/Conditions: * Requires 25% Reduction System.

Comments:/Conditions: Polylok Filter installed
Old Drainfield found while digging Drainfield; will pack dirt btw trenches where old drainfield intersects

INITIAL SITE SKETCH (1" = 40')

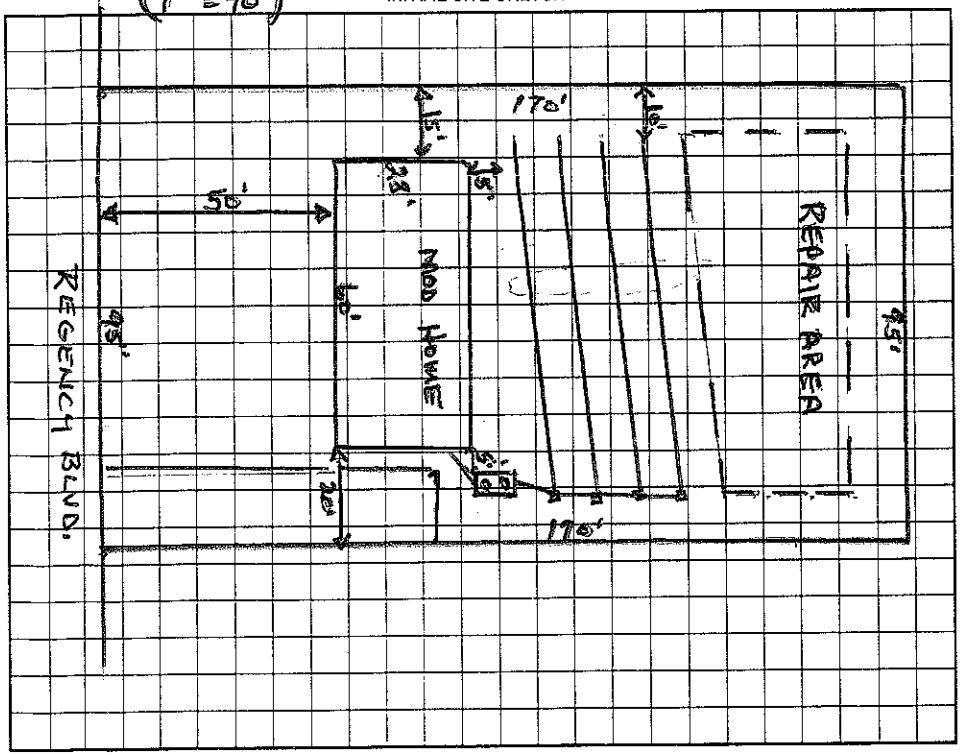


AS BUILT SKETCH

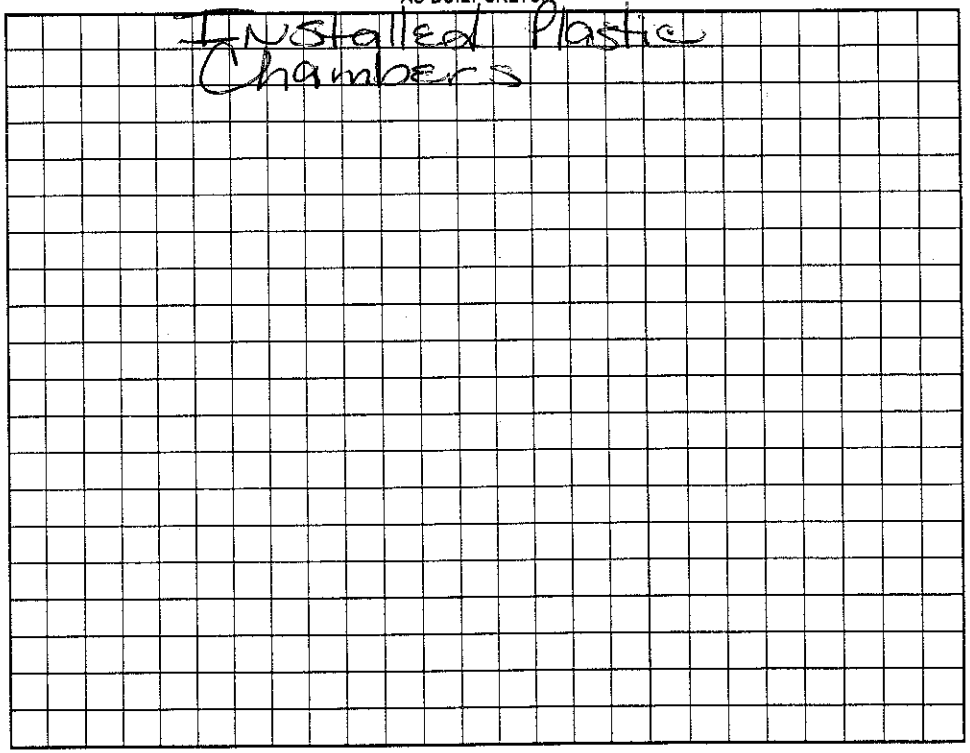


Permit can be suspended or revoked if any false information is supplied toward securing the permit/any unauthorized changes are made to the site/any unauthorized changes are made in the installation of the system. Improvement Permit with plat valid without expiration. Improvement Permit with site plan valid for sixty months. Authorization to Construct is valid for a period equal to that of Improvement Permit – not to exceed sixty months.

Signed: * [signature] date 2-15-01

Improvement Permit by: Wesley Sparks RS. date 2/13/01

Authorization to Construct by: Wesley Sparks RS date 2/13/01

Installed by: Richard Abercrombie

Operation Permit by: [signature] date 3/8/2001

Existing System Inspection by: date

HEALTH DEPT. COPY: WHITE OWNER COPY (FINAL): YELLOW OWNER COPY (INITIAL): PINK