IREDELL COUNTY HEALTH DEPARTMENT

Statesville Phone TR 3-7271 Mooresville Phone NO 3-1271

PERMIT TO INSTALL SEPTIC TANK

Permit NO. 206 Permit Date Oct. 7 1970

Owner REGENCY LAKE Address MOORESVILLE, NC

Installed By WESSON SEPTIC TANK SERVICE Address SHELBY, N.C.

Location of Property


LOT 5 - BLOCK C

Tank		Capacity		Length of Lines		Fixtures	
Block	( )	1000	(✓)	225'	(✓)	No. of Baths	(✓)
Precast	(✓)	1250	( )	250'	( )	Dishwasher	( )
		1500	( )	Other		Garbage Grdr.	( )
		Other				Other	

NOTIFY HEALTH DEPARTMENT AT LEAST EIGHT HOURS BEFORE TANK IS TO BE INSPECTED.

Final Inspection Oct. 7 1970 Approved (✓) Disapproved ( )

Remarks

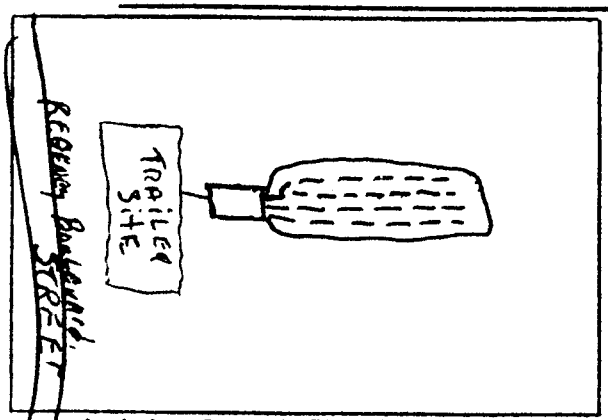

Sketch of Installation

Sanitarian