IREDELL COUNTY HEALTH DEPARTMENT

STATESVILLE 704-878-5305 125.00 Paid MOORESVILLE 704-664-5281 1:30

IMPROVEMENT PERMIT / AUTHORIZATION TO CONSTRUCT / OPERATION PERMIT / EXISTING SYSTEM INSPECTION

PERMIT# 95 072 PIN# 4646 08 7806 DATE 3/26/01

OWNER OR CONTRACTOR Easy Way Inc. PHONE: Business 647-7727 Home

ADDRESS PO Box 3303 Mooresville NC 28117

LOCATION Brawley Sch, L Conversback, L Regency, 0.4 Rt past Community Well

SUBDIVISION Regency Lk BLOCK / SECTION C LOT 5 LOT AREA 0.37 AC SITE CLASS. P5 DESIGN FLOW 360 L.T.A.R. 0.5

Septic Tank: 1000 Gallons; STB 795 Date 10/22/99

Pump Tank: Gallons; PT Date

Pump Make: Model Serial No.

Nitrification Field: No Fields 1 Square Feet 900 Linear Feet 300

No Lines 5@60' Trench Width 36" Max Trench Bottom Depth 28" Gravel Depth —

☒ New System ☐ Repair System Type: I, II, (III), IV, V, VI

System Description: Gravity 25% Reduction

Repair System Description: Panel

Maintenance Agreement Required: ☐ Yes ☐ No

☐ House/Mod. Home ☒ Mobile Home ☐ Business ☐ Other

No. Bedrooms 3 No. Bathrooms 2 No. Employees


Water Supply: ☐ Individual ☐ Public ☒ Community

☐ Slab ☒ Crawl Space ☐ Basement w/plumbing ☐ Basement wo/plumbing

Comments:/Conditions:

Comments:/Conditions:

INITIAL SITE SKETCH

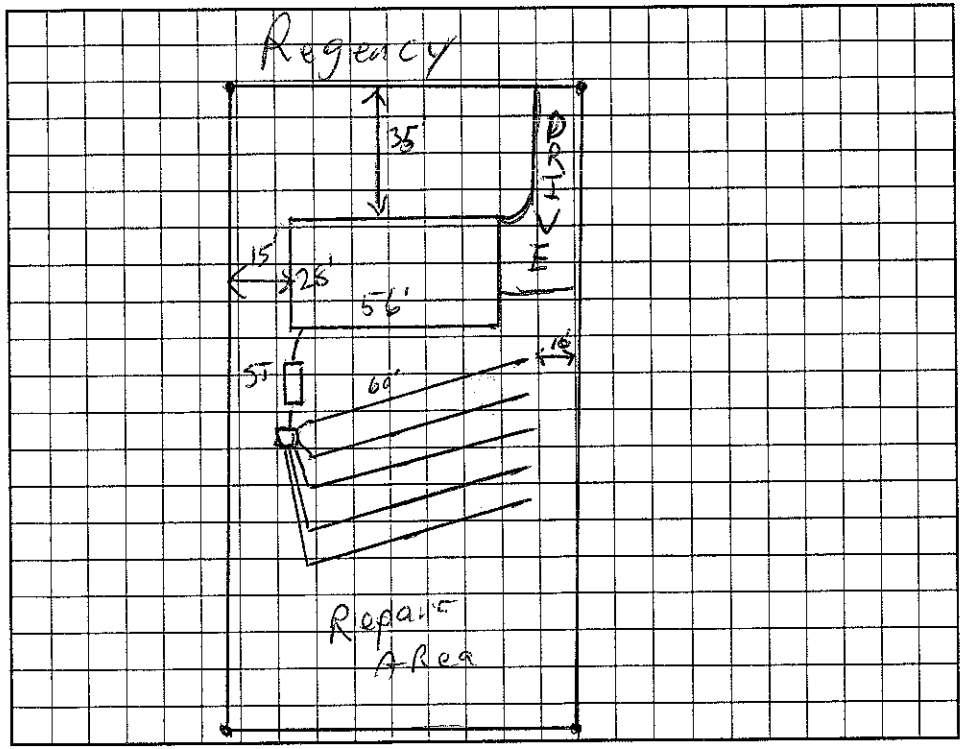

AS BUILT SKETCH

Permit can be suspended or revoked if any false information is supplied toward securing the permit/any unauthorized changes are made to the site/any unauthorized changes are made in the installation of the system. Improvement Permit with plat valid without expiration. Improvement Permit with site plan valid for sixty months. Authorization to Construct is valid for a period equal to that of Improvement Permit – not to exceed sixty months.

Signed: date 3-28-01 Installed by: Craig Thompson

Improvement Permit by: RSI date 3/26/01 Operation Permit by: RSI date 4/9/01

Authorization to Construct by: RSI date 3/26/01 Existing System Inspection by: date

HEALTH DEPT. COPY: WHITE OWNER COPY (FINAL): YELLOW OWNER COPY (INITIAL): PINK