IREDELL COUNTY HEALTH DEPARTMENT

Statesville Phone TR 3-7271 Mooresville Phone NO 3-1271

PERMIT TO INSTALL SEPTIC TANK

Permit NO._____ Permit Date 22 Sept 1920

Owner Regency Lake Village Address Mooresville

Installed By Wesson Address Shelby N.C.


Location of Property Lot 6 Block C

Tank		Capacity		Length of Lines		Fixtures	
Block	( )	1000	(✓)	225'	(✓)	No. of Baths	( )
Precast	(✓)	1250	( )	250'	( )	Dishwasher	( )
		1500	( )	Other_____		Garbage Grdr.	( )
		Other_____				Other_____	

NOTIFY HEALTH DEPARTMENT AT LEAST EIGHT HOURS BEFORE TANK IS TO BE INSPECTED.

Final Inspection 22 Sept 1920 Approved (✓) Disapproved ( )

Remarks Community Well

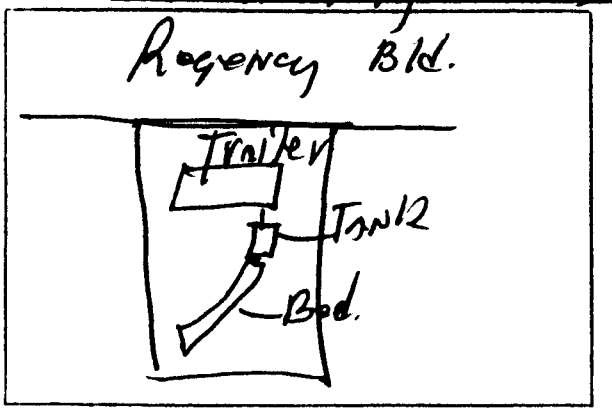

Sketch of Installation

Ray Scoggins RE

Sanitarian