IREDELL COUNTY HEALTH DEPARTMENT

AUTH TO CONSTRUCT

STATESVILLE 704-878-5305 MOORESVILLE 704-664-5281

IMPROVEMENT PERMIT / ~~CERTIFICATE OF COMPLETION~~ / OPERATION PERMIT / EXISTING SYSTEM INSPECTION

PROPERTY DESCRIPTION NO. 25744 DATE 1/29/97 TAX MAP NO. 2K-14-A-36 4646 09 4873 Watershed: ☑ Yes ☐ No

OWNER OR CONTRACTOR AMY LEONARD PHONE: Business _____ Home 662-3484

ADDRESS 708 EMERSON DR MOORESVILLE NC 28115

LOCATION BRAWLEY SCHOOL RD. TL FARMSTEAD - TR PERENNIAL. CORNER OF PERENNIAL & POND HAVEN

SUBDIVISION FARMSTEAD BLOCK / SECTION _____ LOT 36 LOT AREA _____ SITE CLASS. PS DESIGN FLOW 480 L.T.A.R. .3 GPD/FT²

Septic Tank: 1000 Gallons; STB 325 Date 4-1-97

Pump Tank: 1000 Gallons; PT 47 Date 4-8-97

Pump Make: _____ Model _____ Serial No. _____

Nitrification Field: No Fields 1 Square Feet 1200 Linear Feet 400

No Lines 4 @ 100' Trench Width 36" Max Trench Bottom Depth 36" ~~Gravel Depth~~ SAND

☑ New System ☐ Repair System Type: I, II, (III), IV, V, VI

System Description: PUMP CHAMBERED OR STONE

Repair System Description: PUMP PANEL

Maintenance Agreement Required: ☐ Yes ☑ No

☑ House/Mod. Home ☐ Mobile Home ☐ Business ☐ Other

No. Bedrooms 4 No. Bathrooms 4 No. Employees _____


☐ Slab ☑ Crawl Space ☐ Basement w/plumbing ☐ Basement wo/plumbing

Water Supply: ☑ Individual ☐ Community ☐ Public

Comments:

Comments:

INITIAL SITE SKETCH 1"=100'

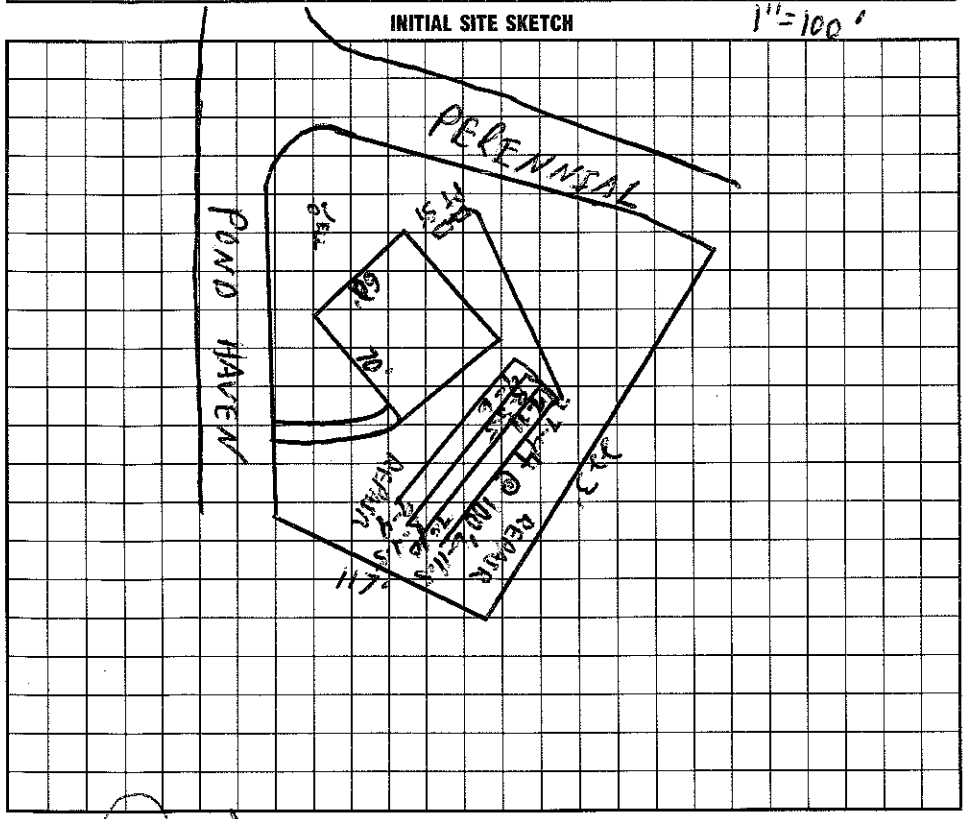

AS BUILT SKETCH

I understand that this permit can be suspended or revoked if any false information is supplied toward securing the permit/any unauthorized changes are made to the site/any unauthorized changes are made in the installation of the system. Improvement Permit is valid for 60 months from date of issuance.

Signed: _____

Improvement Permit by: _____ date 1/29/97

~~Existing System Inspection by:~~ _____ date 1/30/97

AUTHORIZATION TO CONSTRUCT

Installed by: Leonard

Certificate of Completion by: Wesley Sparks R.S. date 6/30/97

Operation Permit by: Wesley Sparks R.S. date 6/30/97

HEALTH DEPT. COPY: WHITE INSPECTION COPY (FINAL): GREEN OWNER COPY (FINAL): YELLOW INSPECTION COPY (INITIAL): PINK OWNER COPY (INITIAL): GOLD