IREDELL COUNTY HEALTH DEPARTMENT

STATESVILLE 704-878-5305 125.00 Paid MOORESVILLE 704-664-5281

IMPROVEMENT PERMIT / AUTHORIZATION TO CONSTRUCT / OPERATION PERMIT / EXISTING SYSTEM INSPECTION

PERMIT# 100906/100907 PIN# 4646 09 6120 DATE 6/25/01

OWNER OR CONTRACTOR Nancy Coffey PHONE: Business 704-664-6359 Home

ADDRESS 121 Wedbud Foot Rd. Mooresville, NC. 28117

LOCATION 1100 TL Conns back TL Regency on L B4 2nd Shelmon

SUBDIVISION Regency Lake BLOCK / SECTION D LOT 4 LOT AREA .34 SITE CLASS PS DESIGN FLOW 360 L.T.A.R. .35

Septic Tank: 1000 Gallons; STB 1100 Date 4/11/04

Pump Tank: Gallons; PT Date

Pump Make: Model Serial No.

Nitrification Field: No Fields 1 Square Feet 771 Linear Feet 257

No Lines 4@64' Trench Width 3' Max Trench Bottom Depth 3' Gravel Depth No

[X] New System [ ] Repair System Type: I, II, (III), IV, V, VI

System Description: GRAV - EZFLOW ORCH, PLASTIC

Repair System Description: 16" PPBPS

Maintenance Agreement Required: [ ] Yes [X] No

[X] House/Mod. Home [ ] Mobile Home [ ] Business [ ] Other

No. Bedrooms 3 No. Bathrooms 3 No. Employees


[ ] Slab [X] Crawl Space [ ] Basement w/plumbing [ ] Basement wo/plumbing

Water Supply: [ ] Individual [ ] Public [X] Community


Comments:/Conditions:

Comments:/Conditions:

INITIAL SITE SKETCH

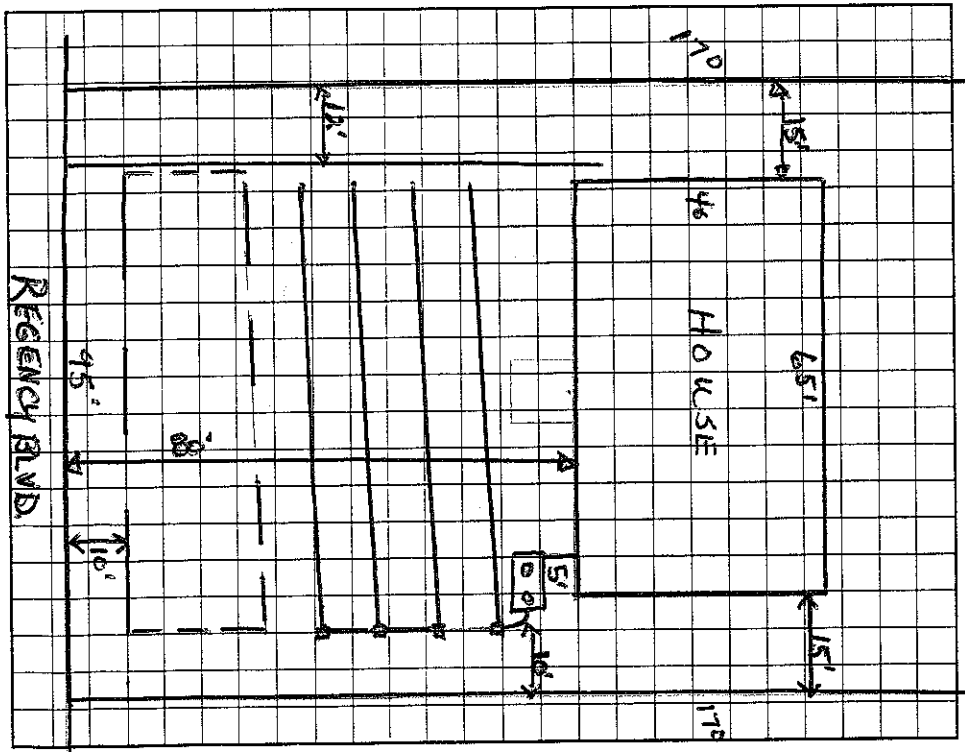

AS BUILT SKETCH

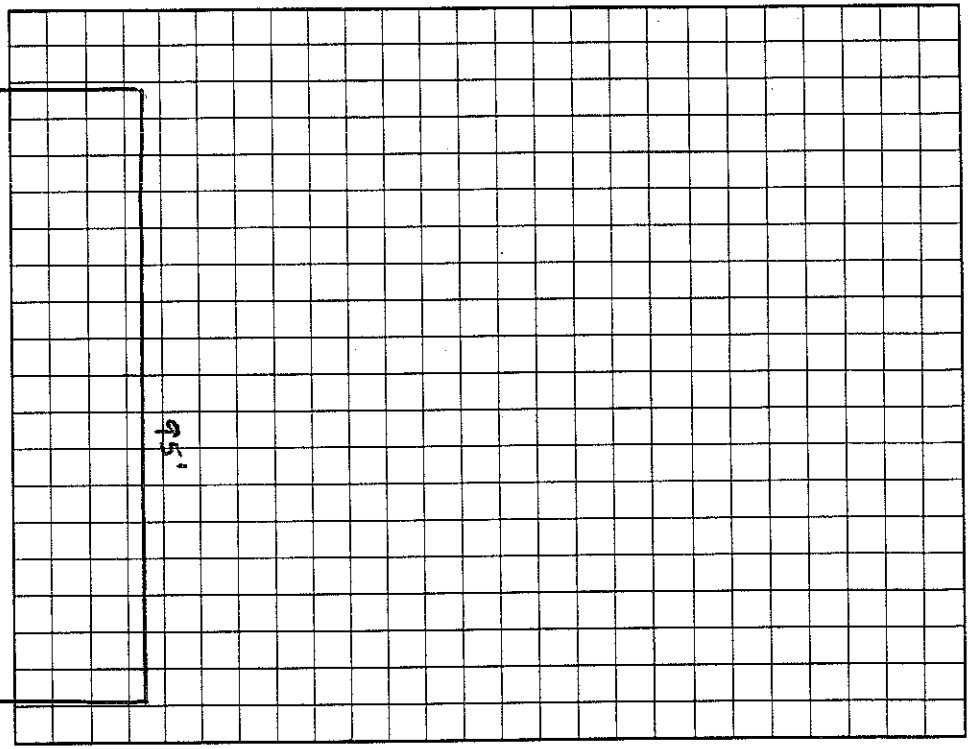

Permit can be suspended or revoked if any false information is supplied toward securing the permit/any unauthorized changes are made to the site/any unauthorized changes are made in the installation of the system. Improvement Permit with plat valid without expiration. Improvement Permit with site plan valid for sixty months. Authorization to Construct is valid for a period equal to that of Improvement Permit – not to exceed sixty months.

Signed: Nancy Coffey date 6/29/01

Improvement Permit by: Wesley Sparks R.S. date 6/25/01

Authorization to Construct by: Wesley Sparks R.S. date 6/25/01

Installed by: David A Umbarger

Operation Permit by: Wesley Sparks R.S. date 6/10/04

Existing System Inspection by: date

HEALTH DEPT. COPY: WHITE OWNER COPY (FINAL): YELLOW OWNER COPY (INITIAL): PINK