IREDELL COUNTY HEALTH DEPARTMENT

Statesville Phone TR 3-7271 Mooresville Phone NO 3-1271

PERMIT TO INSTALL SEPTIC TANK

Permit NO. _____ Permit Date 22 Sept 1970

Owner Regency Lake Village Address Mooresville N.C.

Installed By Wesson Address Shelby N.C.


Location of Property Lot 24 - Block D

Tank		Capacity		Length of Lines		Fixtures	
Block	( )	1000	(-)	225'	(-)	No. of Baths	( )
Precast	(-)	1250	( )	250'	( )	Dishwasher	( )
		1500	( )	Other _____		Garbage Grdr.	( )
		Other _____				Other _____	

NOTIFY HEALTH DEPARTMENT AT LEAST EIGHT HOURS BEFORE TANK IS TO BE INSPECTED.

Final Inspection 22 Sept 1970 Approved (X) Disapproved ( )

Remarks Community well

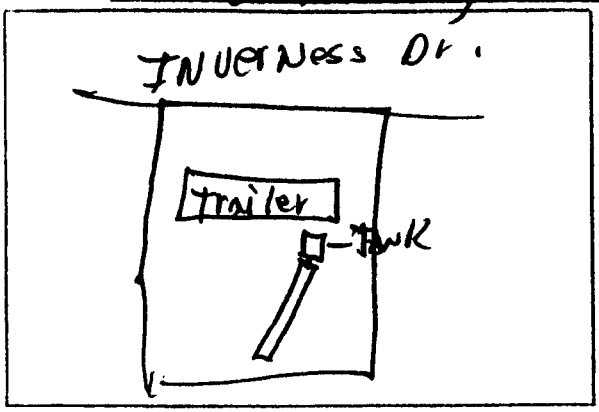

Sketch of Installation

Ivy Scoggins

Sanitarian