9729-4

IREDELL COUNTY HEALTH DEPARTMENT

STATESVILLE 704-878-5305 MOORESVILLE 704-664-5281

IMPROVEMENT PERMIT / AUTHORIZATION TO CONSTRUCT / OPERATION PERMIT / EXISTING SYSTEM INSPECT

PERMIT# 074910 PIN# 4646 09657.2 DATE 7/29/98

OWNER OR CONTRACTOR Tripp (Walton) & Cindy Bunker PHONE: Business (704) 873-8535 Home

ADDRESS 439 Wood St. Statesville, NC 28677

LOCATION Brawley School Rd TL Farmstead Rd TR onto Pondhaven Right side of cul-de-sac

SUBDIVISION Farmstead BLOCK / SECTION LOT 19 LOT AREA SITE CLASS. PS DESIGN FLOW 360gpd L.T.A.R. .31

Septic Tank: 1000 Gallons; STB Date 5/16/98

Pump Tank: Gallons; PT Date

Pump Make: Model Serial No.

Nitrification Field: No Fields 1 Square Feet 400' Linear Feet 200'

No Lines 4@50' Trench Width 24"&36" Max Trench Bottom Depth 30"-36" Gravel Depth N/A

☒ New System ☐ Repair System Type: I II (III) IV V VI

System Description: Gravity - Panel Blk

Repair System Description: Pump - (LPP) Panel Blk

Maintenance Agreement Required: ☐ Yes ☐ No

☒ House/Mod. Home No. Bedrooms 3

☐ Mobile Home No. Bathrooms 2.5

☐ Business No. Employees

☐ Other

☐ Slab ☒ Crawl Space ☐ Basement w/plumbing ☒ Basement wo/plumbing Partial


Water Supply: ☒ Individual ☐ Public ☐ Community

Comments:/Conditions: 50% Reduction in Drainfield Area Keep Septic System at least 10' from PL, 100' from well & 15' (sideslope) of basement.

Comments:/Conditions:

INITIAL SITE SKETCH

Scale 1:100

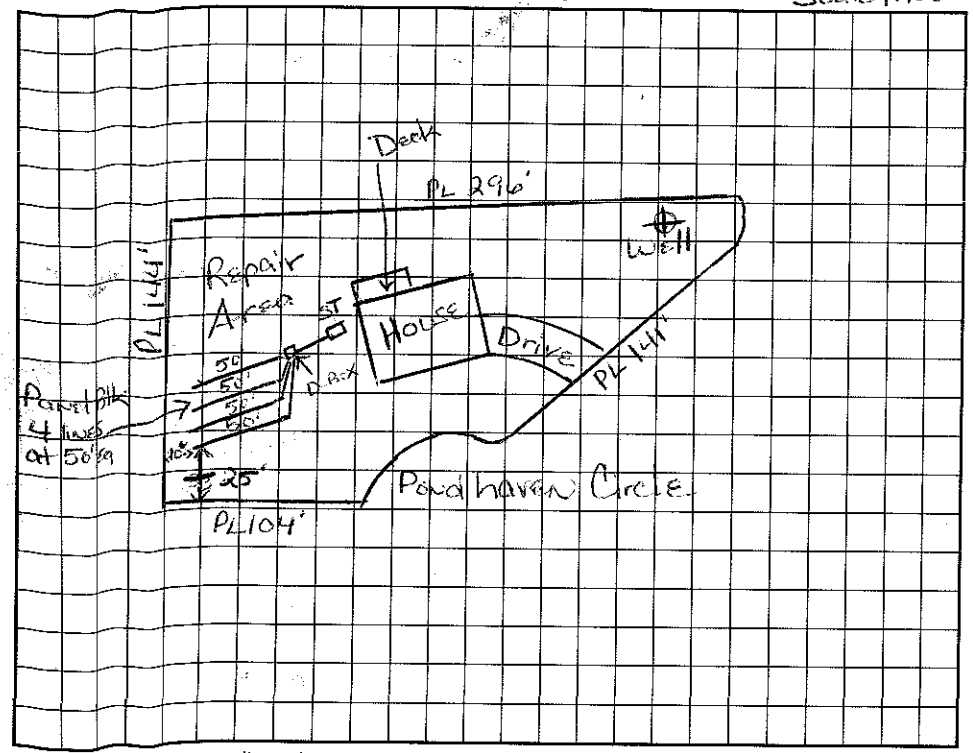

AS BUILT SKETCH

I understand that this permit can be suspended or revoked if any false information is supplied toward securing the permit/any unauthorized changes are made to the site/any unauthorized changes are made in the installation of the system. Improvement Permit with plat valid without expiration. Improvement Permit with site plan valid for sixty months. Authorization to Construct is valid for a period equal to that of Improvement Permit -- not to exceed sixty months.

Signed: Cindy D. Bunker date

Improvement Permit by: Maria H. Tolson date 7/29/98

Authorization to Construct by: Maria H. Tolson date 7/29/98

Installed by: K & K Construction

Operation Permit by: C. [illegible] date 9/17/98

Existing System Inspection by: date

HEALTH DEPT. COPY: WHITE INSPECTION COPY (FINAL): GREEN OWNER COPY (FINAL): YELLOW INSPECTION COPY (INITIAL): PINK OWNER COPY (INITIAL): GOLD