IREDELL COUNTY HEALTH DEPARTMENT

STATESVILLE 704-878-5305 MOORESVILLE 704-664-5281

IMPROVEMENT PERMIT / CERTIFICATE OF COMPLETION / OPERATION PERMIT / EXISTING SYSTEM INSPECTION

PROPERTY DESCRIPTION NO. 20814 DATE 4/12/95 TAX MAP NO. ~~4634~~ 4646141659 Watershed: ☐ Yes ☑ No

OWNER OR CONTRACTOR Louis Lipinsky III PHONE: Business 365-3953 Home

ADDRESS 4628 E Sunnyboy Rd. Charlotte NC. 28276

LOCATION 1100 TL Cane Creek TL Woodchuck TR Crystal Cv. on (E)

SUBDIVISION Crystal Bay BLOCK / SECTION LOT 31 LOT AREA ~.8 SITE CLASS. P DESIGN FLOW 360 L.T.A.R. .3

Septic Tank: 1000 ✓ Gallons; STB 794 Date 1/5/96

Pump Tank: 1000 ✓ Gallons; PT 27 Date 11/29/95

Pump Make: MYERS Model ME 40 MC-II Serial No.

Nitrification Field: No Fields 1 Square Feet 1200 Linear Feet ~200

No Lines 5 Trench Width 24" Max Trench Bottom Depth 36" Gravel Depth 6 SAND

☑ New System ☐ Repair System Type: I, II, III, IV, V, VI

System Description: Pressure Panel - Typ IV.

Repair System Description:

Maintenance Agreement Required: ☑ Yes ☐ No

☑ House/Mod. Home No. Bedrooms 3

☐ Mobile Home No. Bathrooms 2

☐ Business No. Employees

☐ Other

☐ Slab ☑ Crawl Space ☐ Basement w/plumbing ☐ Basement wo/plumbing


Water Supply: ☑ Individual ☐ Community ☐ Public

Comments:


5/10/95 - 1/2 basement on lake side OK'd AWS

Comments:

INITIAL SITE SKETCH

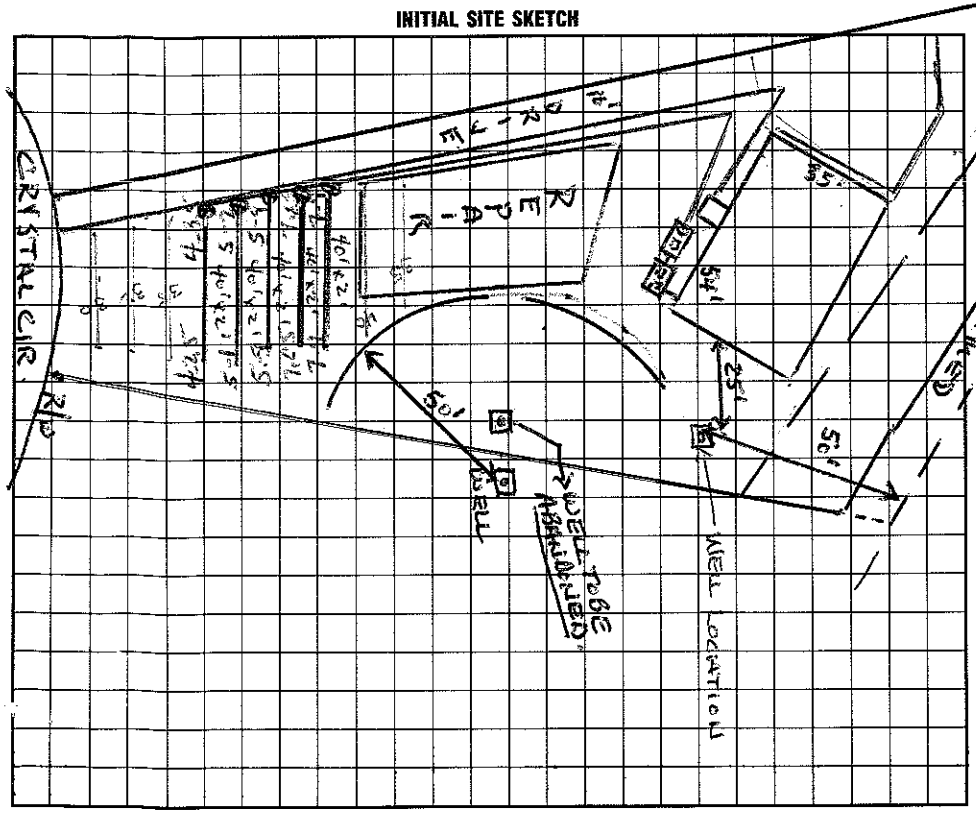

AS BUILT SKETCH

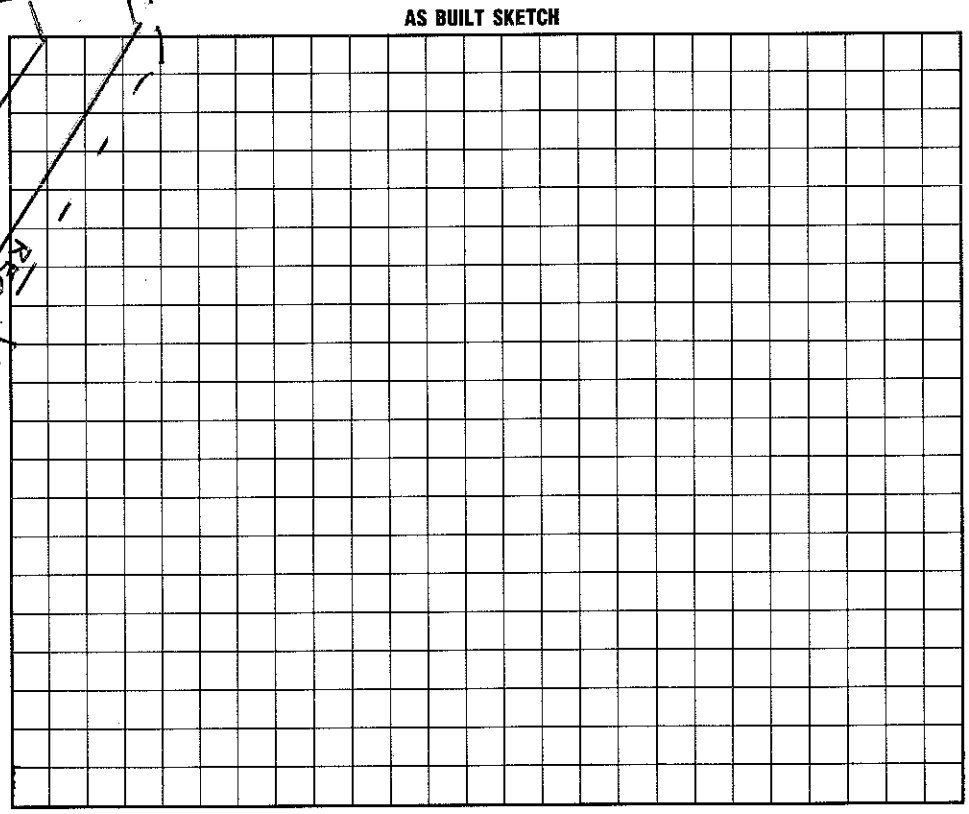

I understand that this permit can be suspended or revoked if any false information is supplied toward securing the permit/any unauthorized changes are made to the site/any unauthorized changes are made in the installation of the system. Improvement Permit is valid for 60 months from date of issuance.

Signed:

Improvement Permit by: Wesley Sparks R.S. date 4/12/95

Existing System Inspection by: date

Installed by: Richard Abernathy

Certificate of Completion by: Wesley Sparks R.S. date 2/29/96

Operation Permit by: Wesley Sparks R.S. date 2/29/96

HEALTH DEPT. COPY: WHITE INSPECTION COPY (FINAL): GREEN OWNER COPY (FINAL): YELLOW INSPECTION COPY (INITIAL): PINK OWNER COPY (INITIAL): GOLD