3 30

# IREDELL COUNTY HEALTH DEPARTMENT

STATESVILLE 704-878-5305 MOORESVILLE 704-~~664~~-5281

## IMPROVEMENT PERMIT / CERTIFICATE OF COMPLETION / OPERATION PERMIT / EXISTING SYSTEM INSPECTION

PROPERTY DESCRIPTION NO. _____ DATE March 19, 97 TAX MAP NO. 4646-14-2727 Watershed: ~~☐~~ Yes ☐ No

OWNER OR CONTRACTOR Betty Gaddy PHONE: Business _____ Home _____

ADDRESS 195 Crystal Circle Mooresville

LOCATION Brawley Sch Rd + L Canvasback TL 2nd Wood Brook Dr TR Crystal Circle ~~#~~ 195

SUBDIVISION Crystal Bay BLOCK / SECTION _____ LOT 30 LOT AREA EXISTING SITE CLASS. _____ DESIGN FLOW _____ L.T.A.R. ~3

Septic Tank: EXISTING Gallons: STB _____ Date _____

Pump Tank: 1000 Gallons; PT 27 Date NO DATE

Pump Make: Myers Model ME3FIIP Serial No. N/A

Nitrification Field: No Fields 2 Square Feet 810+ Linear Feet 270+

No Lines 6 Trench Width _____ Max Trench Bottom Depth _____ Gravel Depth _____

☐ New System ☑ Repair System Type: I, II, III, IV, V, VI

System Description: four bed

Repair System Description: pumped pm chambered

Maintenance Agreement Required: ☐ Yes ☑ No

☑ House/Mod. Home No. Bedrooms ~3

☐ Mobile Home No. Bathrooms _____

☐ Business No. Employees _____

☐ Other _____


☐ Slab ☑ Crawl Space ☐ Basement w/plumbing ☐ Basement wo/plumbing

Water Supply: ☑ Individual ☐ Community ☐ Public


Comments:

Comments:

**INITIAL SITE SKETCH**

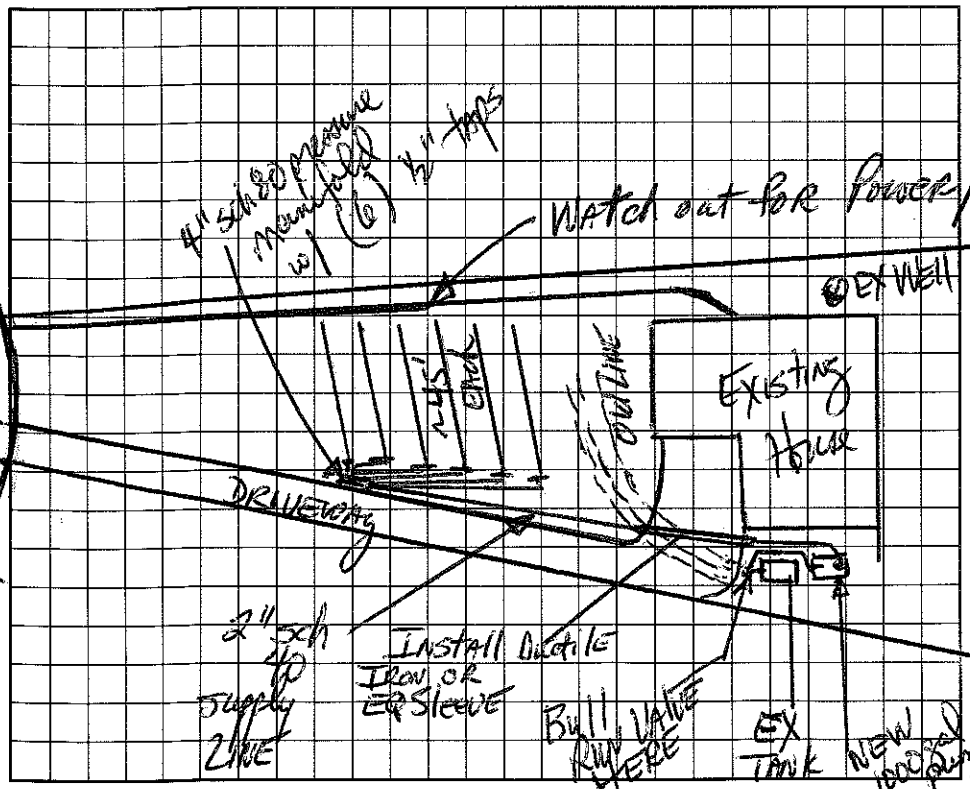


**AS BUILT SKETCH**

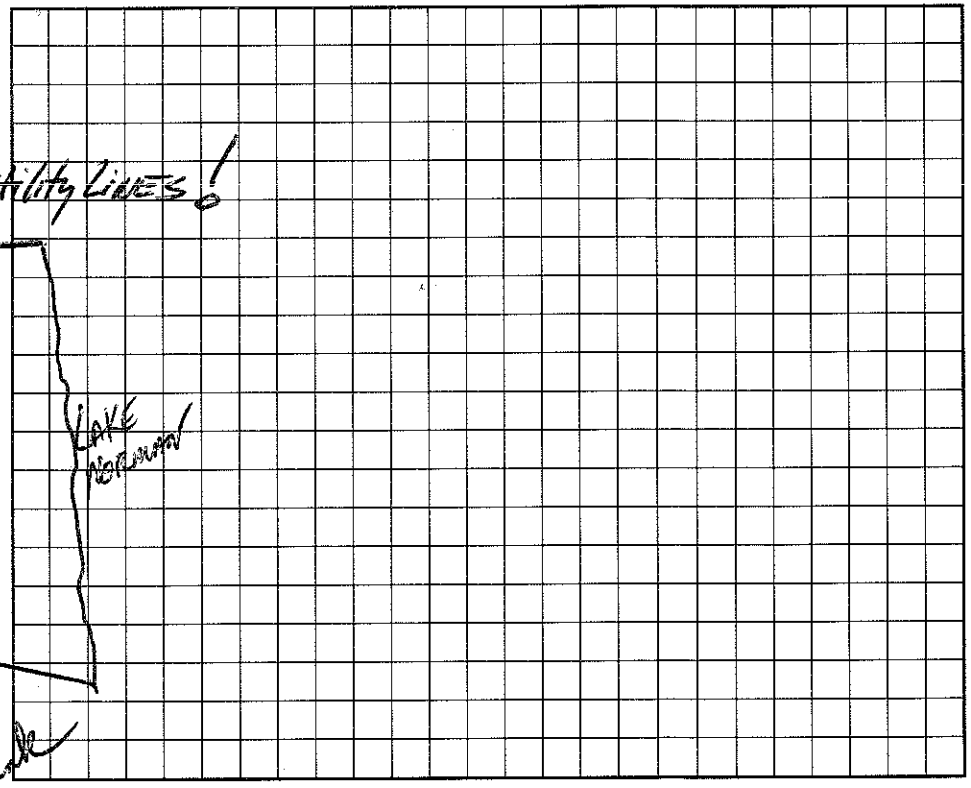


I understand that this permit can be suspended or revoked if any false information is supplied toward securing the permit/any unauthorized changes are made to the site/any unauthorized changes are made in the installation of the system. Improvement Permit is valid for 60 months from date of issuance.

Signed: Betty Gaddy

Improvement Permit by: D.K. Hanson, RS date 3/19/97

Construction ~~Existing System Inspection~~ by: D.K. Hanson, RS date 3/19/97

Installed by: Stanley Septic Service

Certificate of Completion by: Wesley Sparks RS date 3/25/98

Operation Permit by: Wesley Sparks RS date 3/25/98

~~HEALTH DEPT.~~ COPY: WHITE INSPECTION COPY (FINAL): GREEN OWNER COPY (FINAL): YELLOW INSPECTION COPY (INITIAL): PINK OWNER COPY (INITIAL): GOLD