IREDELL COUNTY HEALTH DEPARTMENT

↑ AUTHORIZATION TO CONSTRUCT (4-00)

STATESVILLE 704-878-5305 MOORESVILLE 704-664-5281

IMPROVEMENT PERMIT / ~~CERTIFICATE OF COMPLETION~~ / OPERATION PERMIT / EXISTING SYSTEM INSPECTION

PROPERTY DESCRIPTION NO. 068513 DATE 8/20/97 TAX MAP NO. 4646 14 25 35 4646142855 Watershed: ☑ Yes ☐ No

OWNER OR CONTRACTOR VICKIE WILSON PHONE: Business _____ Home 333-8256

ADDRESS 1121-6 MYRTLE AVENUE CHARLOTTE NC 28203

LOCATION BRAWLEY SCHOOL RD - TL CANVASBACK - TL 2nd WOODDUCK LOOP - TR CRYSTAL CIRCLE ≈ .6 MILE ON LT

SUBDIVISION CRYSTAL BAY BLOCK / SECTION _____ LOT 29 LOT AREA .46AC SITE CLASS. PS DESIGN FLOW 360GPD L.T.A.R. .36GPD/FT²

Septic Tank: 1000 Gallons; STB ~~55~~ 55 Date 9/5/97

Pump Tank: 1000 Gallons; PT 32 Date _____

Pump Make: ZOELLER Model N53C Serial No. 4/2199

Nitrification Field: No Fields 1 Square Feet 400 Linear Feet 200

No Lines 4 @ 50' Trench Width 24" Max Trench Bottom Depth 36" Gravel Depth N/A

☑ New System ☐ Repair System Type: I, II, ☑ III, IV, V, VI

System Description: PUMP PANEL

Repair System Description: SAME

Maintenance Agreement Required: ☐ Yes ☑ No

☑ House/Mod. Home No. Bedrooms 3

☐ Mobile Home No. Bathrooms 2

☐ Business No. Employees _____

☐ Other _____


☐ Slab ☑ Crawl Space ☐ Basement w/plumbing ☐ Basement wo/plumbing

Water Supply: ☑ Individual ☐ Community ☐ Public


Comments:

Comments:

INITIAL SITE SKETCH 1"=40'

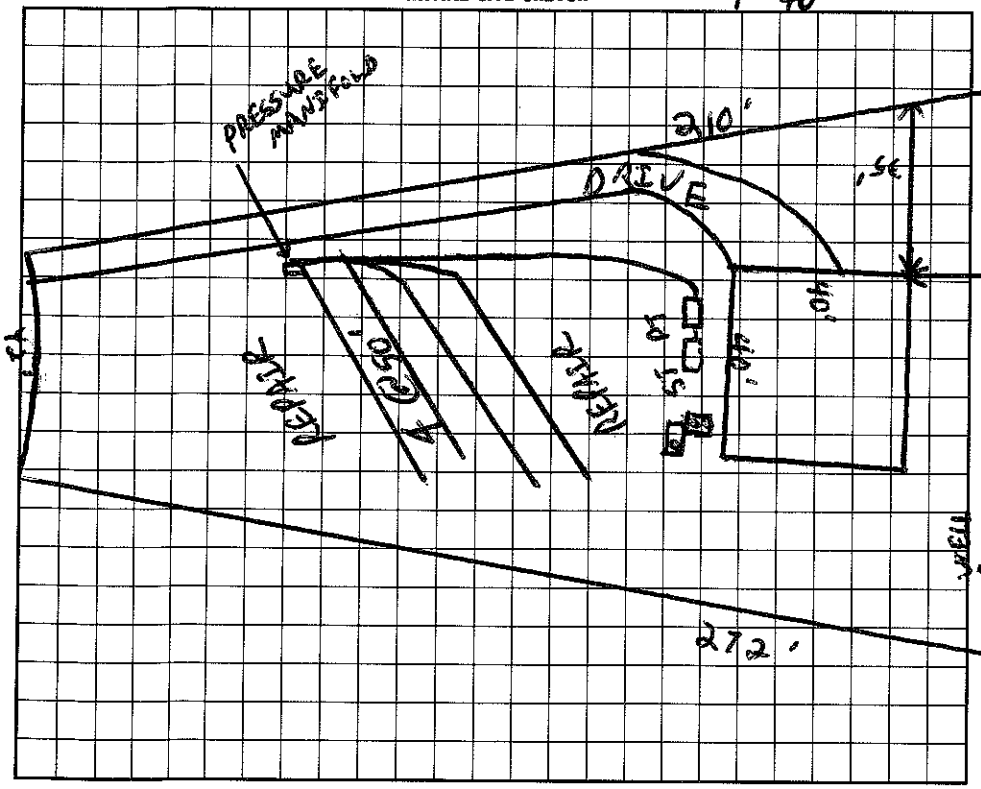

AS BUILT SKETCH

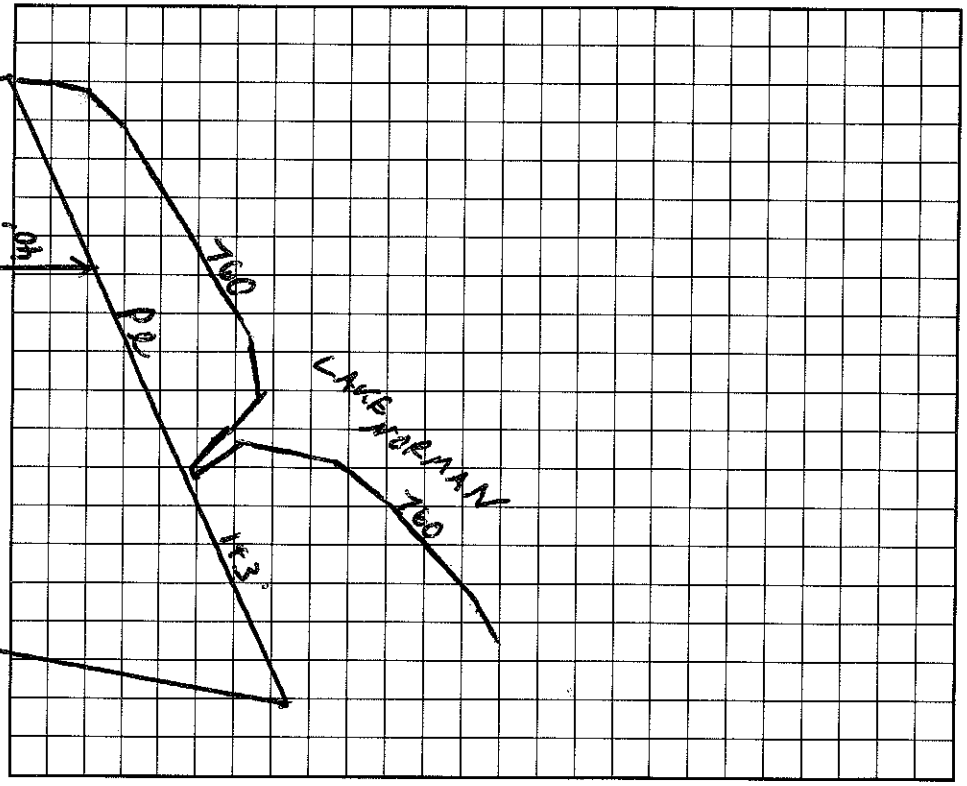

I understand that this permit can be suspended or revoked if any false information is supplied toward securing the permit/any unauthorized changes are made to the site/any unauthorized changes are made in the installation of the system. Improvement Permit is valid for 60 months from date of issuance.

Signed: Vickie W. Wilson

Improvement Permit by: C. Ricky Freeman date 8/20/97

AUTHORIZATION TO CONSTRUCT Existing System Inspection by: C. Ricky Freeman date 8/26/97

Installed by: D+M Enterprises

Certificate of Completion by: Maina M. Dolan RS date 1/21/2000

Operation Permit by: Maina M. Dolan date 1/21/2000

HEALTH DEPT. COPY: WHITE INSPECTION COPY (FINAL): GREEN OWNER COPY (FINAL): YELLOW INSPECTION COPY (INITIAL): PINK OWNER COPY (INITIAL): GOLD