Repair 4646142905 11.0

IREDELL COUNTY HEALTH DEPARTMENT

STATESVILLE 704-878-5305 MOORESVILLE 704-664-5281

IMPROVEMENT PERMIT / AUTHORIZATION TO CONSTRUCT / OPERATION PERMIT / EXISTING SYSTEM INSPECTION

PERMIT # Repair PIN # ~~4646153072~~ DATE 8-15-2012

OWNER or APPLICANT Clifford Hecht PHONE: Business 704 962 6694 Home:

OWNER or APPLICANT ADDRESS P.O. Box 5351 #187

LOCATION / DIRECTIONS Brawley School Rd TL Canvasback TL 2nd Woodduck TR Crystal Circle ~.6 mile on Left

SUBDIVISION Crystal Bay BLOCK / SECTION LOT # 28 LOT AREA DESIGN FLOW 360 gpd L.T.A.R. .35

Exist

Septic Tank ~1000 Gallons: STB Date

Pump Tank 1000g Gallons: PT 360 Date 8-9-2012

Pump Make E-ONE Model DH1VE05 Serial #

Nitrification Field No Fields 1 No Lines 6 Linear Feet ~180+

Trench Width 36" Max. Trench Bottom Depth 36" Gravel Depth N/A

☐ New System ☒ Repair ☐ Expansion System Type I II (III) IV V VI

System Description: Gravity Conventional (Bed)

Repair System Description: Pump + PM - 25% Reduct.

Maintenance Agreement Required ☐ YES ☒ NO

☐ GRAVITY ☒ PRESSURE

☒ Residence No. Bedrooms 3

☐ Business No. Persons

☐ Other No. Employees

☐ Slab ☐ Crawl Space


☒ Basement w/plumbing ☐ Basement w/o plumbing

Water Supply: ☒ Private ☐ Public ☐ Community


Comments / Conditions: ** Must Keep Septic System at least 50ft from any well & 5ft from = Property line. Must stay min 8ft from basement per 15ANCAC 18A.1951(c)(2)

Comments / Conditions: ** Discharge of all wastewater (including "Gray water") must go directly to an approved wastewater system permitted for that specific use. Pump to Interim ST

INITIAL SITE SKETCH

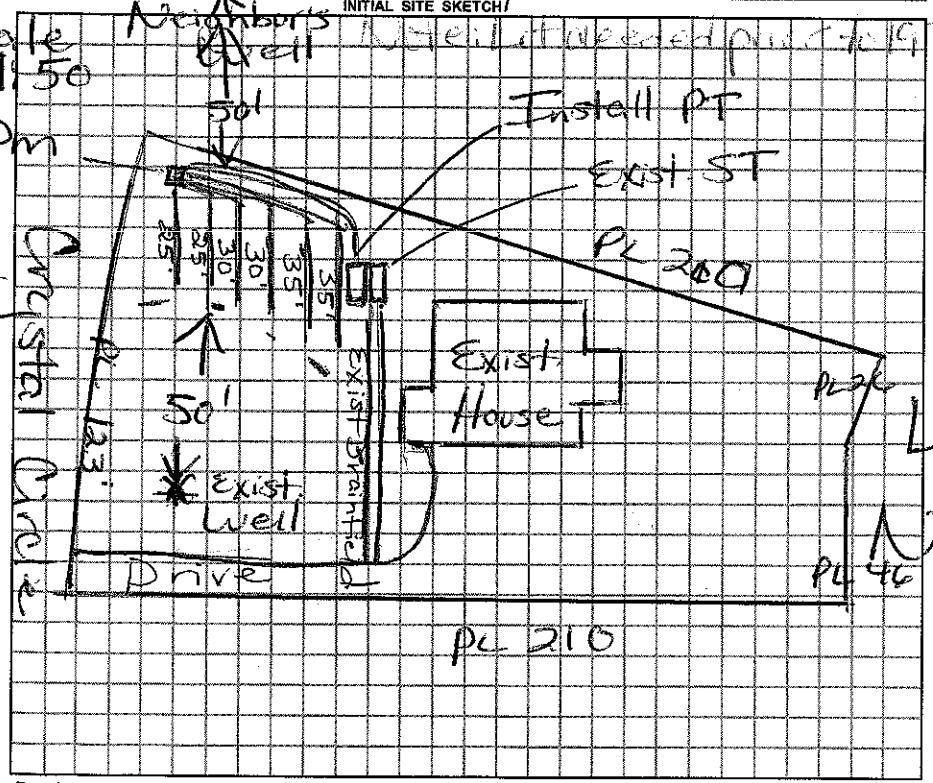

AS BUILT SKETCH

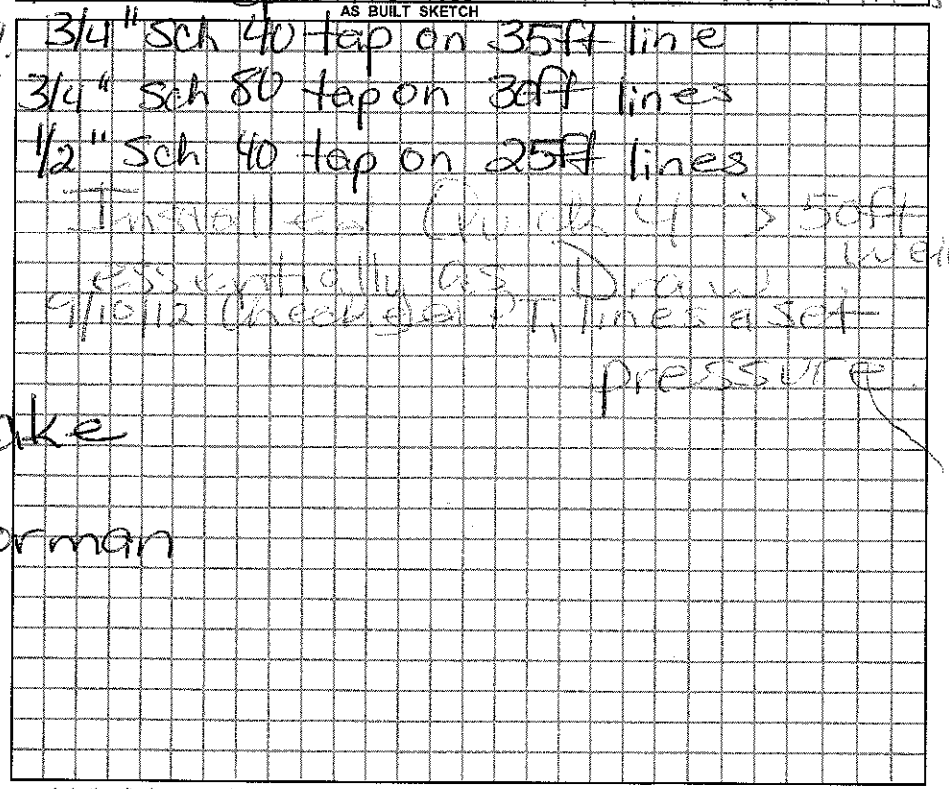

Permit can be suspended or revoked if any false information is supplied toward securing the permit / any unauthorized changes are made to the site / any unauthorized changes are made in the installation of the system.

☐ IMPROVEMENT PERMIT w / plat valid without expiration. ☐ IMPROVEMENT PERMIT w / site plan valid for 60 mos. ☐ AUTHORIZATION TO CONSTRUCT valid for period equal to IMPROVEMENT PERMIT-not to exceed 60 mo.

Owner / Applicant Signature: Date 8/16/12

Improvement Permit by: Marie H. Roberts RS Date 8/15/12

Authorization to Construct by: Marie H. Roberts RS Date 8/15/12

Installed by: Septic

Operation Permit by: Marie H. Roberts RS Date: 9/10/12

Existing System Inspected by: Date:

YOU SHOULD CONTACT A LOCATOR SERVICE PRIOR TO ANY EXCAVATION.

WHITE COPY Environmental Health YELLOW COPY (Final) Owner / Applicant PINK COPY (Initial) Owner / Applicant