IREDELL COUNTY HEALTH DEPARTMENT - *ENVIRONMENTAL HEALTH* ☐ STATESVILLE OFFICE 704-878-5305 ☐ MOORESVILLE OFFICE 704-664-5281

IMPROVEMENT PERMIT / AUTHORIZATION TO CONSTRUCT / OPERATION PERMIT / EXISTING SYSTEM INSPECTION

PERMIT # 168818 PIN # 4646151788 DATE 11-10-2011

OWNER Thomas Katsamas APPLICANT: Chad Goddin PHONE: Home/Cell # Business # 704363-7302

SITE ADDRESS 275 Wood Duck Lp OWNER / APPLICANT ADDRESS 684 Normandy Rd. M'ville, NC 28117

SITE DIRECTIONS Brawley School Rd TL Canvasback TL Wood Duck, On right

SUBDIVISION Lakeshore Est BLOCK / SECTION LOT # 37 LOT AREA .59Ac DESIGN FLOW 360gpd L.T.A.R. .3

Exist

Septic Tank 1000 Gallons: STB Date

Pump Tank 1000 Gallons: PT Date

Pump Make Model Serial #

No. Nitrification Fields: 1 No. Lines 5 Linear Feet 200

Trench Width 24" Max. Trench Bottom Depth Gravel Depth N/A

☐ New System ☐ Repair ☐ Expansion System Type I II III IV V VI

System Description: Existing Pump-Up-Panel Blk

Repair System Description: Same

Maintenance Agreement Required ☐ YES ☐ NO System installed prior to 1997

☒ Residence No. Bedrooms 3

☐ Business No. Persons

☐ Other No. Employees

☐ Slab ☐ Crawl Space

☐ Basement w/plumbing ☐ Basement w/o plumbing

Water Supply

☒ Private

☐ Public

☐ Community

Comments / Conditions


Keep addition at least 25Ft from well.

* It is Suggested to have ST pumped out & Maintenance done to Septic System.


Existing Septic System appears to be functioning okay at time of inspection. Addition should not impact Septic System. No of Bedrooms will remain 3.

INITIAL SITE SKETCH

Scale ~1:60

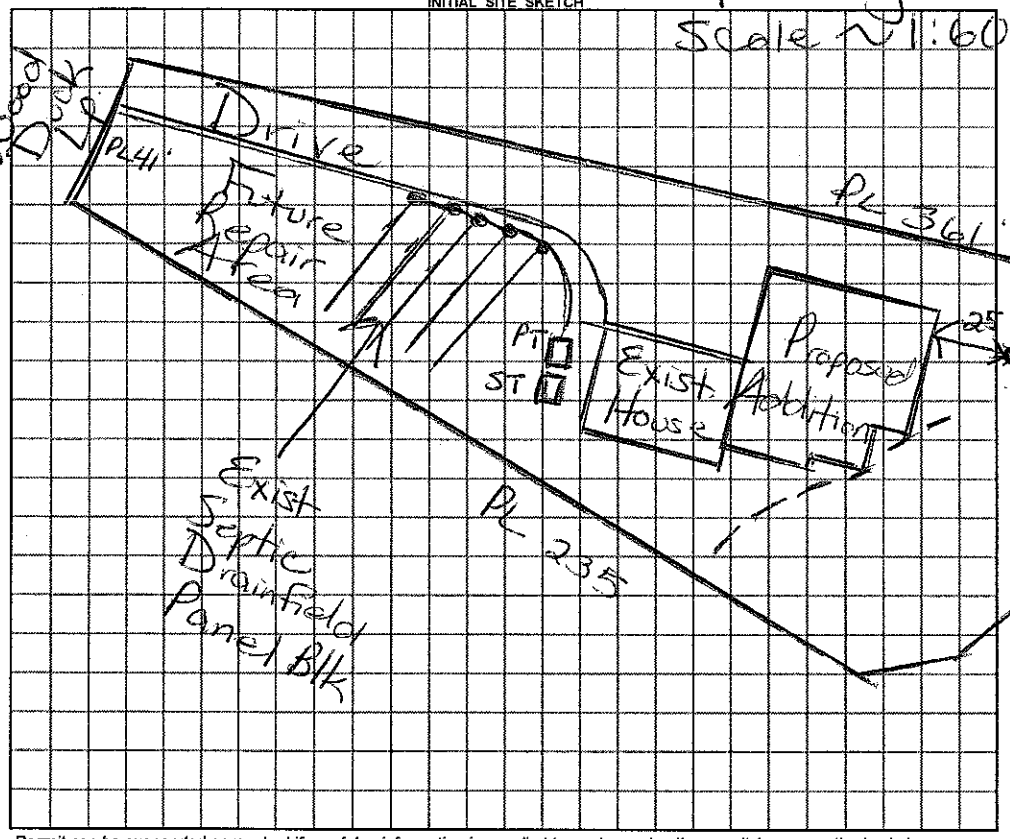

AS BUILT SKETCH

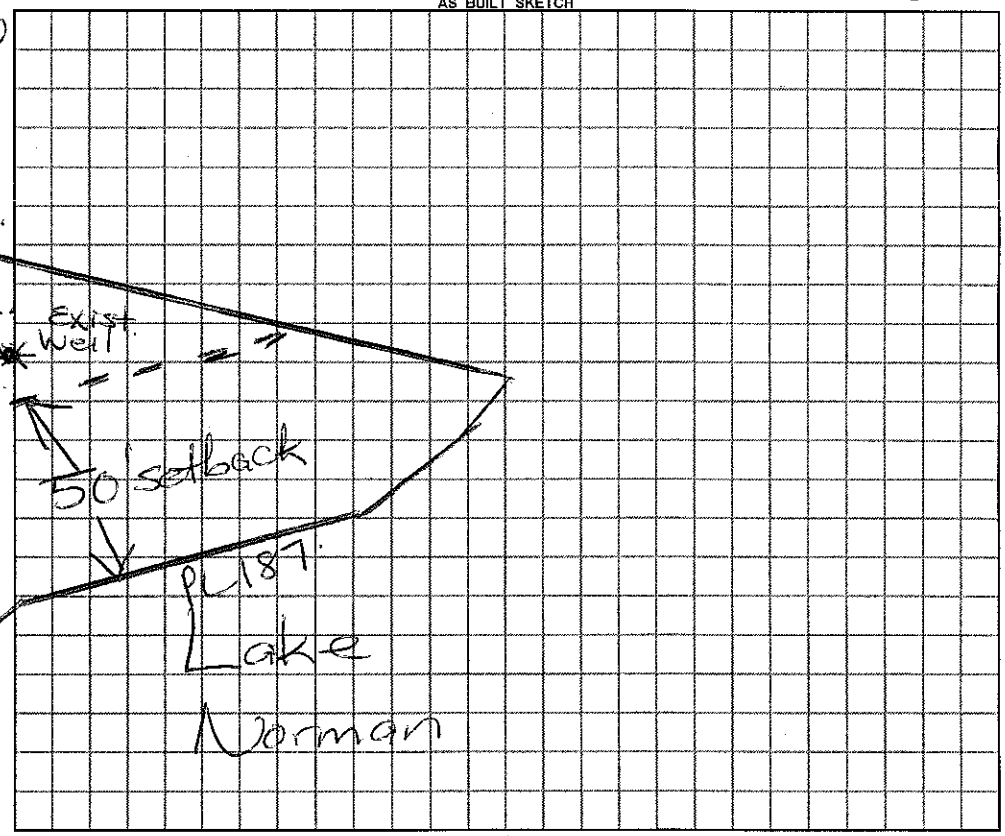

Permit can be suspended or revoked if any false information is supplied toward securing the permit / any unauthorized changes are made to the site / any unauthorized changes are made in the installation of the system.

☐ ***IMPROVEMENT PERMIT*** with plat valid without expiration. ☐ ***IMPROVEMENT PERMIT*** with plat valid without expiration. site plan valid 60 mo. ☐ ***AUTHORIZATION TO CONSTRUCT*** valid for period equal to IMPROVEMENT PERMIT--not to exceed 60 mo.

Owner / Applicant Signature: Date 11/23/11 Installed by: F.J. Ervin 1/1/1989

IMPROVEMENT PERMIT by: ***REHS*** Date OPERATION PERMIT by: ***REHS*** Date

AUTHORIZATION TO CONSTRUCT by: ***REHS*** Date Existing System Inspected by: ***REHS*** Date 11/10/11

YOU SHOULD CONTACT A LOCATOR SERVICE PRIOR TO ANY EXCAVATION

White Copy -- Environmental Health YELLOW COPY (Final) Owner / Applicant PINK COPY (Initial) Owner / Applicant