IREDELL COUNTY HEALTH DEPARTMENT

Statesville Phone TR 3-7271 Mooresville Phone NO 3-1271

PERMIT TO INSTALL SEPTIC TANK

Permit No. _____ Permit Date 13 Jan 1966

Owner Leland Lee Address Mooresville, N.C.

Installed By Carl Dockery Address Mooresville N.C.


Location of Property Crystal Bay, Lot 26

Tank		Capacity		Length of Lines		Fixtures	
Block	( )	1000	(✓)	225'	(✓)	No. of Baths	( )
Precast	(✓)	1250	( )	250'	( )	Dishwasher	( )
		1500	( )	Other _____		Garbage Grdr.	( )
		Other _____				Other _____	

NOTIFY HEALTH DEPARTMENT AT LEAST EIGHT HOURS BEFORE TANK IS TO BE INSPECTED.

Final Inspection 13 Jan 1966 Approved (✓) Disapproved ( )

Remarks Well Not Down. No House

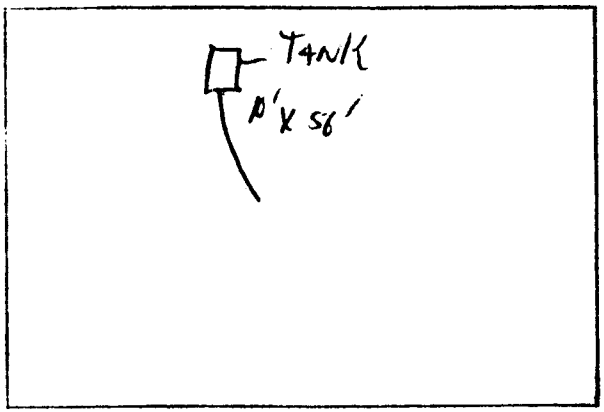

Sketch of Installation

Troy Goggin

Sanitarian