IREDELL COUNTY HEALTH DEPARTMENT

STATESVILLE 704-878-5305 175.00 Paid MOORESVILLE 704-664-5281

A

IMPROVEMENT PERMIT / AUTHORIZATION TO CONSTRUCT / OPERATION PERMIT / EXISTING SYSTEM INSPECTION

PERMIT# 100714 PIN# ~~4636 97 0863~~ 4644-16-1399

OWNER OR CONTRACTOR Pernell Jones PHONE: Business Home 704-664-2845 DATE 6/7/01

ADDRESS 109 Hanbor Cove Lane Mooresville, NC. 28117

LOCATION 1100 TL Conover Beck L on 1st Woodduck Lp. on (R)

SUBDIVISION Lakeside BLOCK / SECTION LOT 31 LOT AREA .41 AC SITE CLASS PS DESIGN FLOW 360 L.T.A.R. .3

Septic Tank: 1000 Gallons; STB 354 Date 7/20/01

Pump Tank: Gallons; PT Date

Pump Make: Model Serial No.

Nitrification Field: No Fields 1 Square Feet 900* Linear Feet 300*

No Lines 5@60' Trench Width 3' Max Trench Bottom Depth 3'

☒ New System ☐ Repair System Type: I, II, (III) IV, V, VI

System Description: GRAVITY - HDS & CH. PLASTIC

Repair System Description: SAME

Maintenance Agreement Required: ☐ Yes ☒ No

Gravel Depth SAND. ☐ Slab ☒ Crawl Space ☐ Basement w/plumbing ☐ Basement wo/plumbing

☒ House/Mod. Home No. Bedrooms 3

☐ Mobile Home No. Bathrooms 3

☐ Business No. Employees

☐ Other


Water Supply: ☐ Individual ☐ Public ☒ Community

Comments:/Conditions:


Comments:/Conditions:

(1" = 40')

INITIAL SITE SKETCH

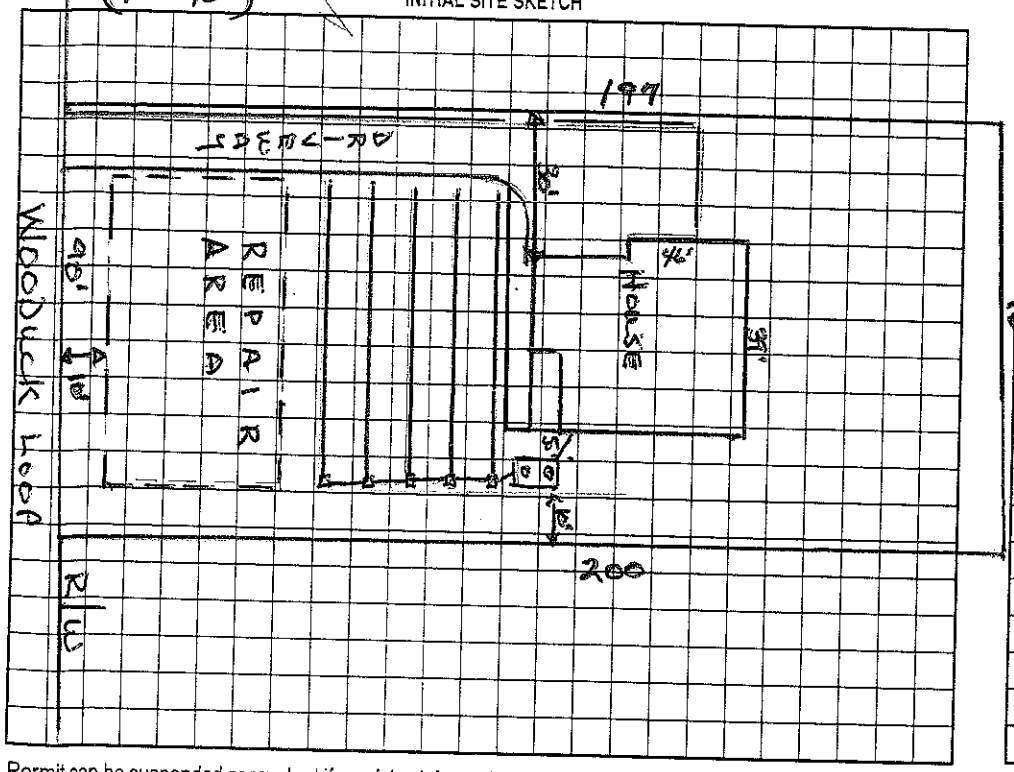

AS BUILT SKETCH

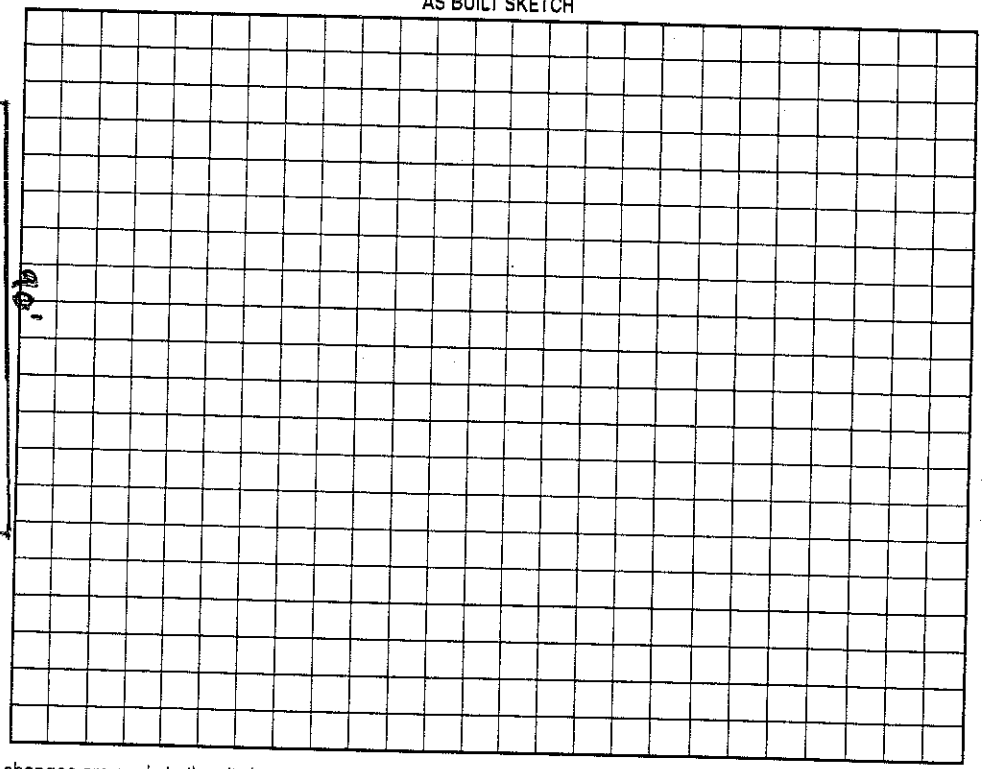

Permit can be suspended or revoked if any false information is supplied toward securing the permit/any unauthorized changes are made to the site/any unauthorized changes are made in the installation of the system. Improvement Permit with plat valid without expiration. Improvement Permit with site plan valid for sixty months. Authorization to Construct is valid for a period equal to that of Improvement Permit – not to exceed sixty months.

Signed: * [signature] date 6-8-01

Improvement Permit by: Wesley Sparks R.S. date 6/7/01

Authorization to Construct by: Wesley Sparks R.S. date 6/7/01

Installed by: McLeod Const. Co.

Operation Permit by: Wesley Sparks R.S. date 9/27/01

Existing System Inspection by: date

HEALTH DEPT. COPY: WHITE OWNER COPY (FINAL): YELLOW OWNER COPY (INITIAL): PINK