PROVEMENT PERMIT / AUTHORIZATION TO CONSTRUCT / OPERATION PERMIT / EXISTING SYSTEM INSP

IIT# 114614 PIN# 4646 16 1489 DATE 8/9/03

ER OR CONTRACTOR Monica Tamminga PHONE: Business 704-907-6787 Home

ESS 19609 Conchmont Trace Cornelius, NC 28031

TION 1100 TL Conover Creek TL 1st Woodcreek Loop, Lot on (L)

IVISION LAKESHORE ESTATES BLOCK / SECTION LOT 30 LOT AREA .58 Ac SITE CLASS PS DESIGN FLOW 360 L.T.A.R. .7

ic Tank: 1000 Gallons: ST8 Date

p Tank: 1000 Gallons: PT Date

p Make: Model Serial No

lication Field: No Fields 1 Square Feet 420/630 Linear Feet 210

lines 3@70' Trench Width 2-3 Max Trench Bottom Depth 3'

[X] New System [ ] Repair System Type: I, II, III, [IV], V, VI

System Description: Infiltrator 16" PPBPS

Repair System Description: Same

Maintenance Agreement Required: [X] Yes [ ] No

[X] House/Mod. Home No. Bedrooms 3

[ ] Mobile Home No. Bathrooms 3

[ ] Business No. Employees

[ ] Other

Water Supply: [X] Individual [ ] Public [ ] Community

Gravel Depth 0 [ ] Slab [X] Crawl Space [ ] Basement w/plumbing [ ] Basement w/o plumbing


ments/Conditions: 2' on 8' CNTRS / 3' on 9' CNTRS

One 3/16" hole/panel eliminated at 10:00


2:00 position Pump = 28-29 GPM

Comments/Conditions:

INITIAL SITE SKETCH

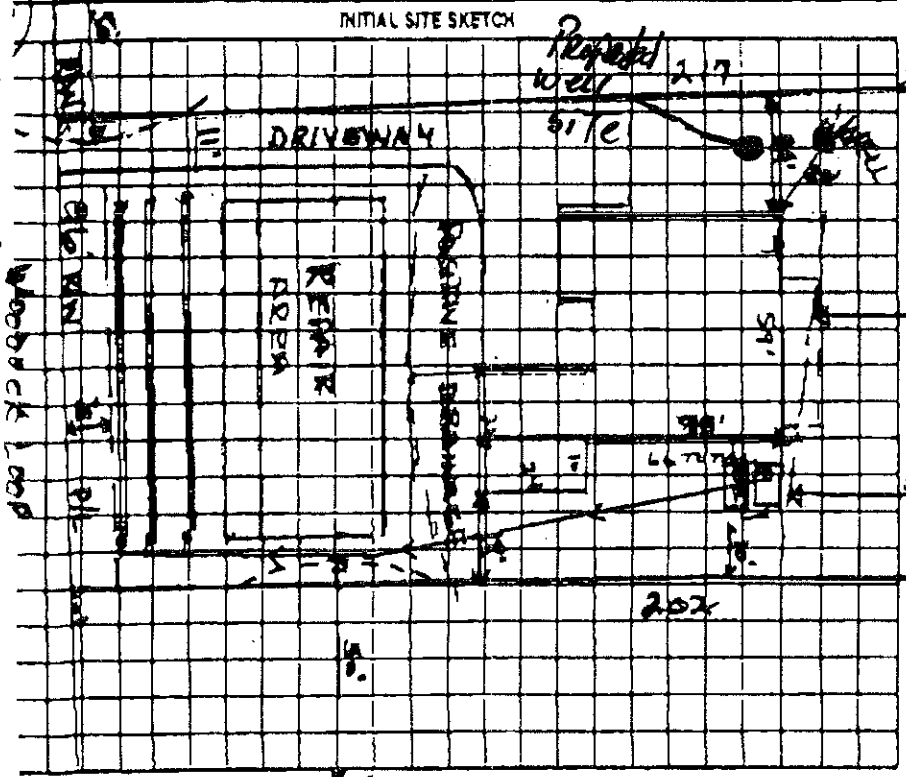

AS BUILT SKETCH

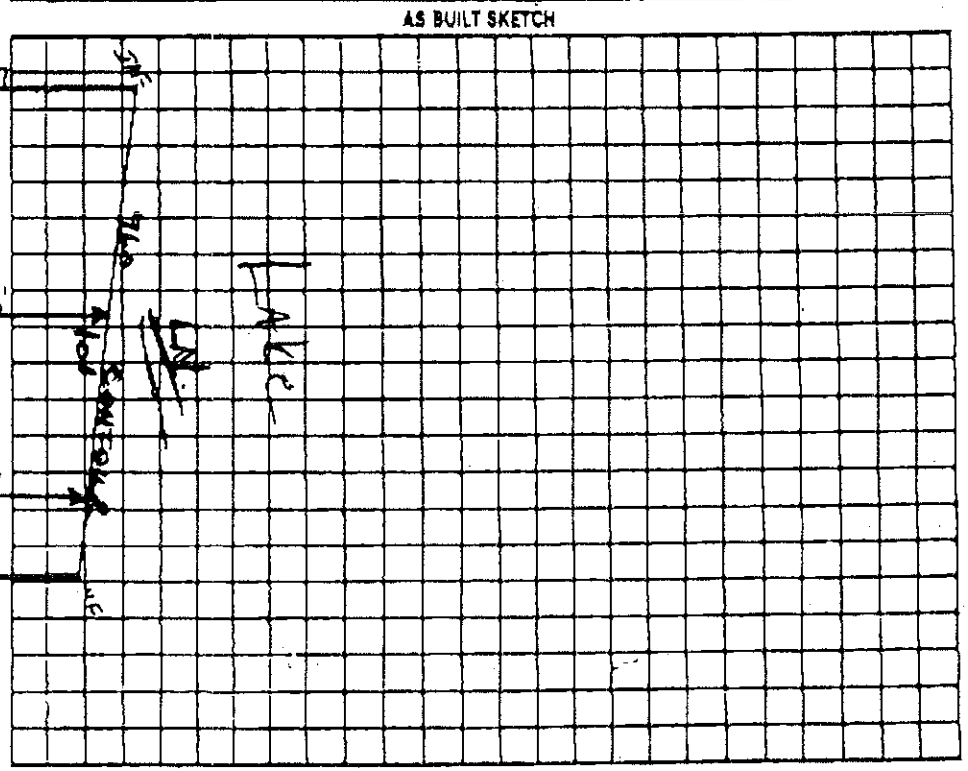

it can be suspended or revoked if any false information is supplied toward securing the permit/any unauthorized changes are made to the site/any unauthorized changes are made in the installation of the system. Improvement it with plat valid without expiration. Improvement Permit with site plan valid for sixty months. Authorization to Construct is valid for a period equal to that of Improvement Permit – not to exceed sixty months.

d: * Killough date 9-11-03 Installed by:

vement Permit by: Wesley Sparks R.S. date 9/9/03 Operation Permit by: date

rization to Construct by: Wesley Sparks R.S. date 9/9/03 Existing System Inspection by: date

HEALTH DEPT. COPY: WHITE OWNER COPY (FINAL): YELLOW OWNER COPY (INITIAL): PINK