IREDELL COUNTY HEALTH DEPARTMENT

STATESVILLE 704-878-5305 — MOORESVILLE 704-664-5281

IMPROVEMENT PERMIT / AUTHORIZATION TO CONSTRUCT / OPERATION PERMIT / EXISTING SYSTEM INSPECTION

Repair

PERMIT# N/A PIN# Repair 4646-16-1660 DATE 6-21-04

OWNER OR CONTRACTOR William Barlow PHONE: Business Home 576-3393

ADDRESS 241 Wood duck Loop Mooresville NC 28117

LOCATION Brawley School Rd TL Canvasback TL Wood duck Loop # 241 Wood duck

SUBDIVISION Lakeshore East BLOCK / SECTION LOT 29 LOT AREA SITE CLASS. PS DESIGN FLOW 480gpd L.T.A.R.

Install New

Septic Tank: 1000 Gallons; STB 794 Date 5/25/04

Pump Tank: Gallons; PT Date

Pump Make: Model Serial No.

Nitrification Field: No Fields Square Feet Linear Feet

No Lines Trench Width EXISTING Max Trench Bottom Depth Gravel Depth

☒ New System ☒ Repair System Type: I II III IV V VI

System Description: Existing Drainfield Gravity Convention

Repair System Description:

Maintenance Agreement Required: ☐ Yes ☒ No

☒ House/Mod. Home ☐ Mobile Home ☐ Business ☐ Other

No. Bedrooms 4 No. Bathrooms 2 No. Employees

☐ Slab ☐ Crawl Space ☐ Basement w/plumbing ☐ Basement wo/plumbing


Water Supply: ☒ Individual ☐ Public ☐ Community

Comments/Conditions: Install New ST next to existing ST. Abandoned old ST & hook new SP onto existing Drainfield.


Comments/Conditions:

Not to Scale

INITIAL SITE SKETCH

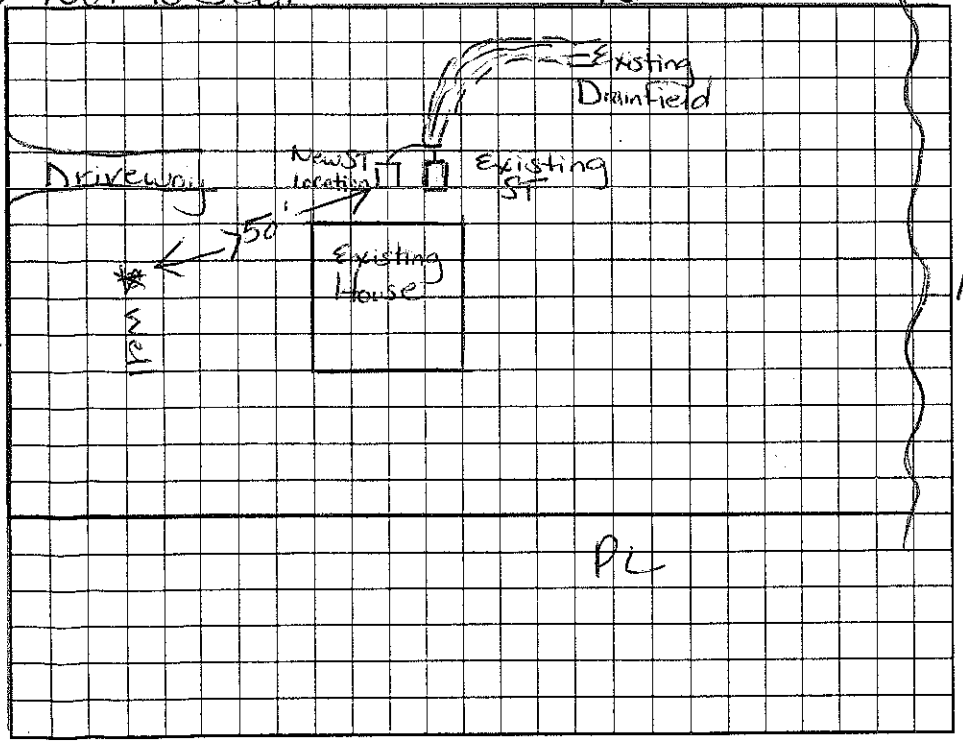

AS BUILT SKETCH

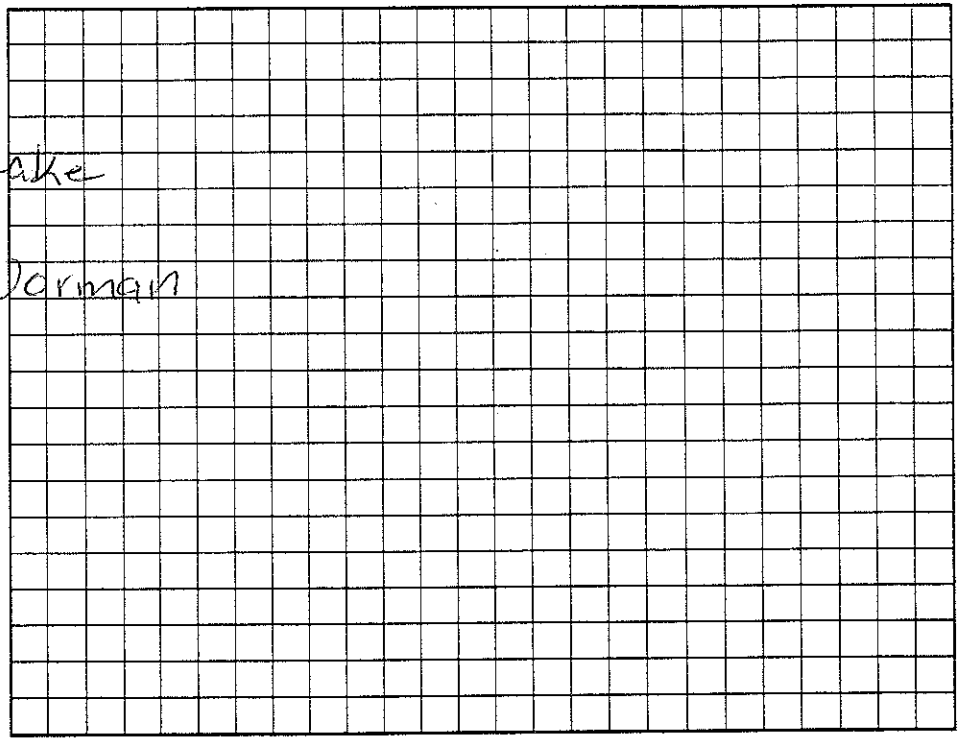

Permit can be suspended or revoked if any false information is supplied toward securing the permit/any unauthorized changes are made to the site/any unauthorized changes are made in the installation of the system. Improvement Permit with plat valid without expiration. Improvement Permit with site plan valid for sixty months. Authorization to Construct is valid for a period equal to that of Improvement Permit – not to exceed sixty months.

Signed: Jim Ammons date 6-29-04 Installed by: Tim Ammons

Improvement Permit by: Maria H. Dotson R.S date 6/22/04 Operation Permit by: Wesley Sparks RS date 7/1/04

Repair

Authorization to Construct by: Maria H. Dotson RS date 6/22/04 Existing System Inspection by: date

HEALTH DEPT. COPY: WHITE OWNER COPY (FINAL): YELLOW OWNER COPY (INITIAL): PINK