IREDELL COUNTY HEALTH DEPARTMENT

STATESVILLE 704-878-5305 MOORESVILLE 704-664-5281

IMPROVEMENT PERMIT / AUTHORIZATION TO CONSTRUCT / OPERATION PERMIT / EXISTING SYSTEM INSPECTION

PERMIT# 127625 PIN# 4646161801 DATE 9-7-05

OWNER OR CONTRACTOR David Dibble Custom Homes PHONE: Business 799-1688 Home Fax 799-1681

ADDRESS P.O. Box 4717 Mooresville, NC 28117

LOCATION Brawley School Rd TL Canvasback TL Wood Duck Loop on left # 233

SUBDIVISION Lakeshore Est. BLOCK / SECTION ____ LOT 27 LOT AREA .509 Acre SITE CLASS. RS DESIGN FLOW 480 gpd L.T.A.R. .3

Septic Tank: 1000 Gallons; STB ____ Date ____

Pump Tank: 1000 Gallons; PT ____ Date ____

Pump Make: Bowles Model WEO-712HV Serial No. 11/11/05

Nitrification Field: No Fields 1 Square Feet 540' Linear Feet 270'

No Lines 4 Trench Width 24" Max Trench Bottom Depth 36" Gravel Depth N/A

[X] New System [ ] Repair System Type: I, II, III, (IV), V, VI

System Description: Pump-LP-Panel Block

Repair System Description: Deeded prior to 1983

Maintenance Agreement Required: [X] Yes [ ] No

[X] House/Mod. Home [ ] Mobile Home [ ] Business [ ] Other

No. Bedrooms 4 No. Bathrooms 3.5 No. Employees ____

[ ] Slab [ ] Crawl Space [X] Basement w/plumbing [ ] Basement wo/plumbing


Water Supply: [X] Individual [ ] Public [ ] Community

Comments/Conditions: Keep Septic System at least 10' from PL, 50' from lake & > 50' from well. Keep well at least 25' from house. * Sleeve supply line under drive with ductile iron or bury > 30 inches.

Comments/Conditions: Note: Keep Drainfield at least 25' from basement. * Lot deeded prior to 1983 - therefore can not require 100% repair.

Scale 1:50

INITIAL SITE SKETCH

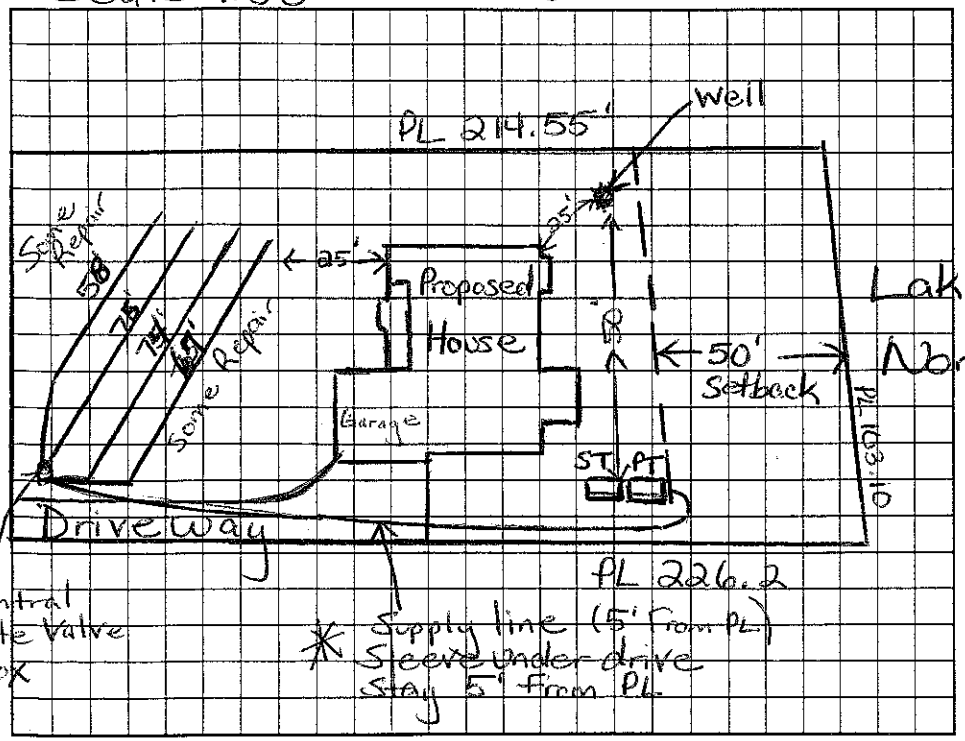

AS BUILT SKETCH

3/9/06 - ROCK MASONS HAVE BEEN DRIVING OVER DRAINFIELD - I TOLD THEM NO MORE IN FRONT OF ORBISON CREW - ACWS

Permit can be suspended or revoked if any false information is supplied toward securing the permit/any unauthorized changes are made to the site/any unauthorized changes are made in the installation of the system. Improvement Permit with plat valid without expiration. Improvement Permit with site plan valid for sixty months. Authorization to Construct is valid for a period equal to that of Improvement Permit – not to exceed sixty months.

Signed: [signature] date 9/7/05

Improvement Permit by: [signature] RS date 9/7/05

Authorization to Construct by: [signature] RS date 9/7/05

Installed by: Robinson Septic

Operation Permit by: [signature] RS date 5/30/06

Existing System Inspection by: ____ date ____

HEALTH DEPT. COPY: WHITE OWNER COPY (FINAL): YELLOW OWNER COPY (INITIAL): PINK