IREDELL COUNTY HEALTH DEPARTMENT

Statesville Office (704) 878-5305 Mooresville Office (704) 660-3625 PERMIT # 219364

IMPROVEMENT PERMIT / AUTHORIZATION TO CONSTRUCT / OPERATION PERMIT / EXISTING SYSTEM

PIN # 4646-16-2107

APPLICANT: ELLEN SCHOTT APPLICANT ADDRESS: 261 WOOD DUCK LOOP - Mooresville

SITE ADDRESS: SAME PHONE: ALT. PHONE:

SITE DIRECTIONS: RSR, TL CANVASBACK, TL WOOD DUCK, ON L

SUBDIVISION: LAKESHORE ESTATES SECTION: — LOT # 33 LOT AREA: DESIGN FLOW: 480 L.T.A.R.: .3 (.15R)

Septic Tank Ex. 1000 (gal) STB Date
Pump Tank (gal) PT Date
Pump Make Model Serial #
Nitrification Fields 1 # Lines 1 Linear Ft: 35'
Trench Width 24" Max. Trench Bottom Depth 36" Gravel Depth —

☐ New System ☐ Repair ☐ Expansion System Type: I II (III) IV V VI
System Description: PANEL BLOCK
Repair System Description: DRIP
Maintenance Agreement Required: ☐ YES ☒ NO
☒ GRAVITY ☐ PRESSURE

☐ Residence No. Bedrooms 4
☐ Business No. Persons 8
☒ Other No. Employees
☐ Slab ☐ Crawl Space
☐ Basement w/plumbing ☐ Basement w/o plumbing

Water Supply: ☒ Private ☐ Public ☐ Community

Comments / Conditions:

DECK

INITIAL SITE SKETCH

SEE PLAN FROM MICHAEL ATHANAS & ASSOCIATES

AS BUILT SKETCH

1 - Old D Box in bad condition and bad layout of adjustment > Replaced with new 11 hole Box and 4 feed levelers.

2 - Old levelers were only allowing 1 line to receive waste. New box adjusted properly.

Permit can be suspended or revoked if any false information is supplied toward securing the permit / any unauthorized changes are made to the site / any unauthorized changes are made in the installation of the system. **CONTACT A LOCATOR SERVICE PRIOR TO ANY EXCAVATION**


☐ **IMPROVEMENT PERMIT** *with plat valid without expiration.* ☐ **IMPROVEMENT PERMIT** *with site plan valid for 60 mos.* ☒ **AUTHORIZATION TO CONSTRUCT** *valid for period equal to IMPROVEMENT PERMIT--not to exceed 60 mo.*

Owner / Applicant Signature: Ellen Schott Date: 6-27-16 Installed by: A1 Backhoe

IMPROVEMENT PERMIT by: RALLS Date: 6-10-16 OPERATION PERMIT by: W Sparks Date: 9/6/16

AUTHORIZATION TO CONSTRUCT by: RALLS Date: 6-10-16 Existing System Inspected by: Date:

Health Dept. Copy - WHITE Applicant (Final Approval) - YELLOW Applicant (Conditional Approval) - PINK

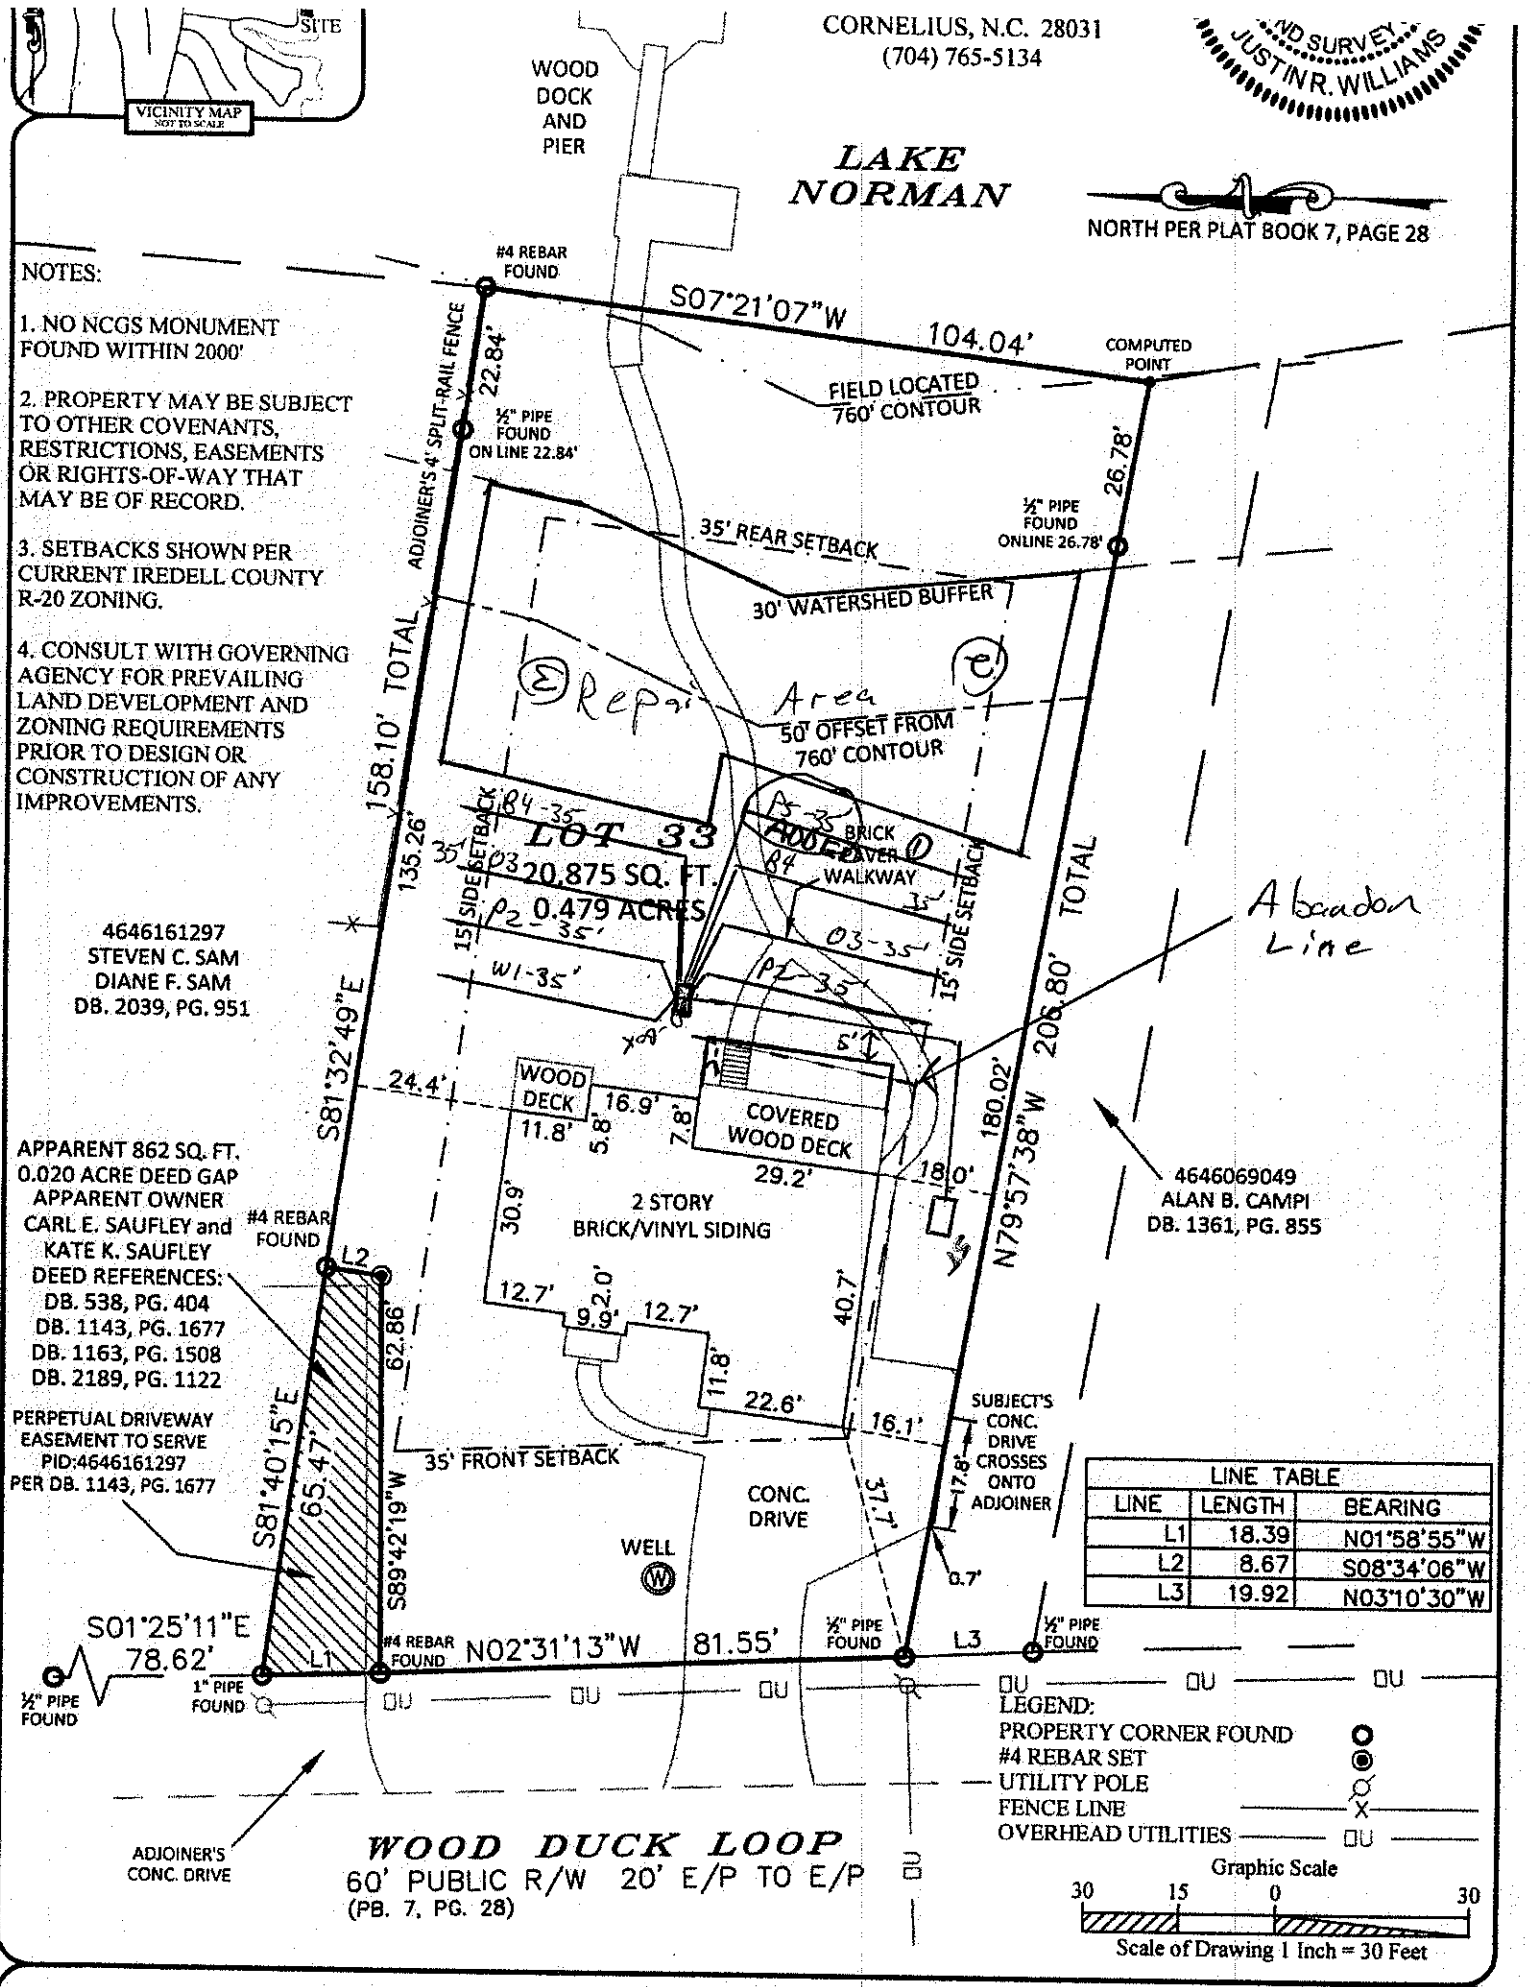

Physical Survey of Lot 33 of Lakeshore Estates