IREDELL COUNTY HEALTH DEPARTMENT

Statesville Office (704) 878-5305 Mooresville Office (704) 660-3625 PERMIT # 223024

IMPROVEMENT PERMIT / AUTHORIZATION TO CONSTRUCT / OPERATION PERMIT / EXISTING SYSTEM

PIN # 4646-17-0011

APPLICANT: LINDA DAVIDSON APPLICANT ADDRESS: 223 WOOD DUCK LOOP MOORESVILLE

SITE ADDRESS: SAME PHONE: 704-929-0996 ALT. PHONE:

SITE DIRECTIONS: BSR, TL CANVASRACK, TL WOOD DUCK, ON L

SUBDIVISION: LAKE SHORE ESTATES SECTION: — LOT # 25 LOT AREA: DESIGN FLOW: 360 L.T.A.R.:

Septic Tank 1000 (gal) STB 760 Date 8-1
Pump Tank (gal) PT Date
Pump Make Model Serial #
Nitrification Fields EXISTING # Lines Linear Ft:
Trench Width Max. Trench Bottom Depth Gravel Depth


☐ New System ☑ Repair ☐ Expansion System Type: I (II) III IV V VI
System Description:
Repair System Description: TANK
Maintenance Agreement Required: ☐ YES ☒ NO
☒ GRAVITY ☐ PRESSURE

☒ Residence ☐ Business ☐ Other ☐ Slab ☑ Basement w/plumbing
No. Bedrooms 3 No. Persons 6 No. Employees ☐ Crawl Space

Water Supply: ☒ Private ☐ Public ☐ Community ☐ Basement w/o plumbing

Comments / Conditions: PUMP CRUSH FILL OLD TANK

INITIAL SITE SKETCH

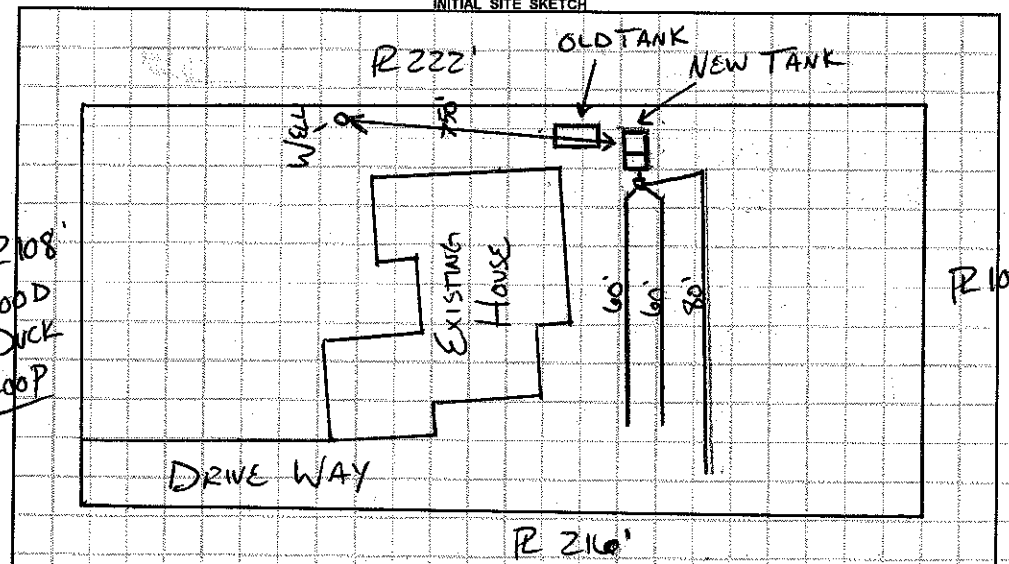

AS BUILT SKETCH

1"=50'

Permit can be suspended or revoked if any false information is supplied toward securing the permit / any unauthorized changes are made to the site / any unauthorized changes are made in the installation of the system. **CONTACT A LOCATOR SERVICE PRIOR TO ANY EXCAVATION**

☐ **IMPROVEMENT PERMIT** *with plat valid without expiration.* ☒ **IMPROVEMENT PERMIT** *with site plan valid for 60 mos.* ☑ **AUTHORIZATION TO CONSTRUCT** *valid for period equal to IMPROVEMENT PERMIT--not to exceed 60 mo.*

Owner / Applicant Signature: Linda Davidson - POA Date: 11/17/16 Installed by:

IMPROVEMENT PERMIT by: RA Date: 11-16-16 OPERATION PERMIT by: RA ENTZ Date: 11-22-16

AUTHORIZATION TO CONSTRUCT by: RA Date: 11-16-16 Existing System Inspected by: Date:

Health Dept. Copy - WHITE Applicant (Final Approval) - YELLOW Applicant (Conditional Approval) - PINK