IREDELL COUNTY HEALTH DEPARTMENT

ATESVILLE 704-878-5305 MOORESV 4-664-5281

IMPROVEMENT PERMIT / AUTHORIZATION TO CONSTRUCT / OPERATION PERMIT / EXISTING SYSTEM INSPECTION

PERMIT# 106181/121254 PIN# ~~4696 20 7611.15~~ 4646 17 7982 DATE 8/15/02

OWNER OR CONTRACTOR DIENST ENTERPRISES INC / Ryan Homes PHONE: Business 309-0123 Home

ADDRESS 14315 W. CATAWBA AVE SUITE 200 CORNELIUS NC 28031

LOCATION WILLIAMSON - TR SUNDOWN RD - TR SUNDOWN COVE - TL CORONA - ON LT

SUBDIVISION ESTATES @ SUNDOWN BLOCK / SECTION LOT 15 LOT AREA 28817 SITE CLASS. PS DESIGN FLOW ~~480GPD~~ L.T.A.R. .256 GPD/FT²

Septic Tank: 1000 Gallons; STB 794 Date 7-2-04
Pump Tank: 1000 Gallons; PT 27 Date 6-28-04
Pump Make: Goulds Model WE0312M Serial No. SD5192687
Nitrification Field: No Fields 1 Square Feet 660 Linear Feet 330
No Lines 3@110' Trench Width 24" Max Trench Bottom Depth 36" Gravel Depth N/A

☑ New System ☐ Repair System Type: I, II, III, (IV), V, VI
System Description: LP PANEL
Repair System Description: SAME
Maintenance Agreement Required: ☑ Yes ☐ No

☑ House/Mod. Home No. Bedrooms 4
☐ Mobile Home No. Bathrooms 4
☐ Business No. Employees
☐ Other


☐ Slab ☑ Crawl Space ☐ Basement w/plumbing ☐ Basement wo/plumbing

Water Supply: ☐ Individual ☐ Public ☑ Community


Comments:/Conditions: 1) INLINE PUMP FILTER TO BE INSTALLED

Comments:/Conditions: Installed Panel Blk Drainfield essentially as Drawn. Checked tanks & lines 8/5/04 MJ Elect, alarm & pressure 8/27/04 MJ

INITIAL SITE SKETCH 1"=50'

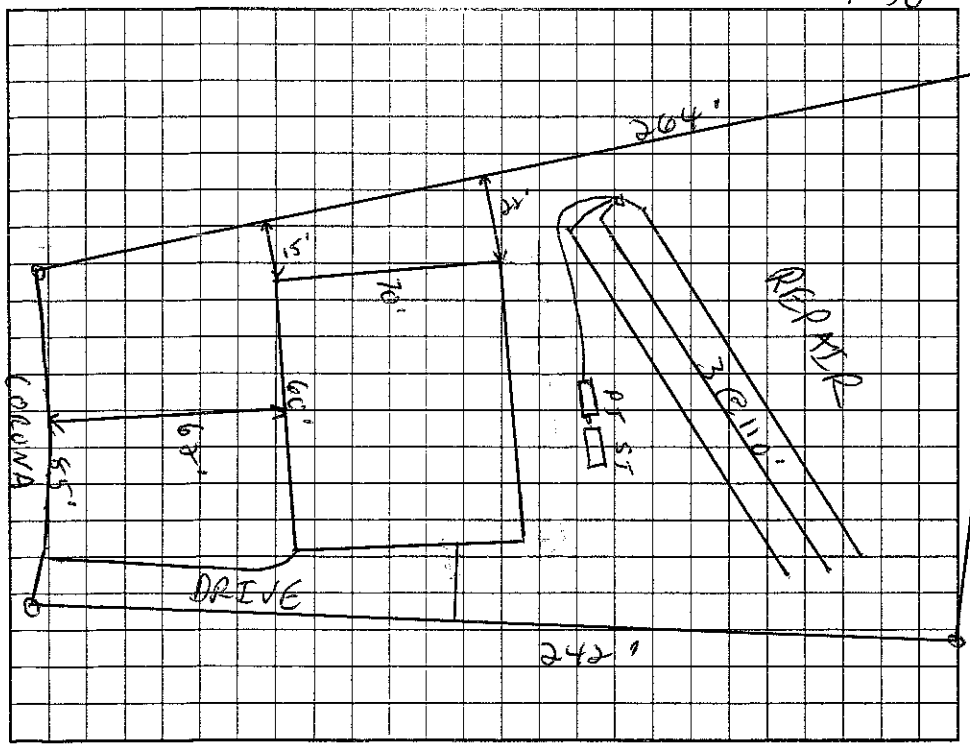

AS BUILT SKETCH

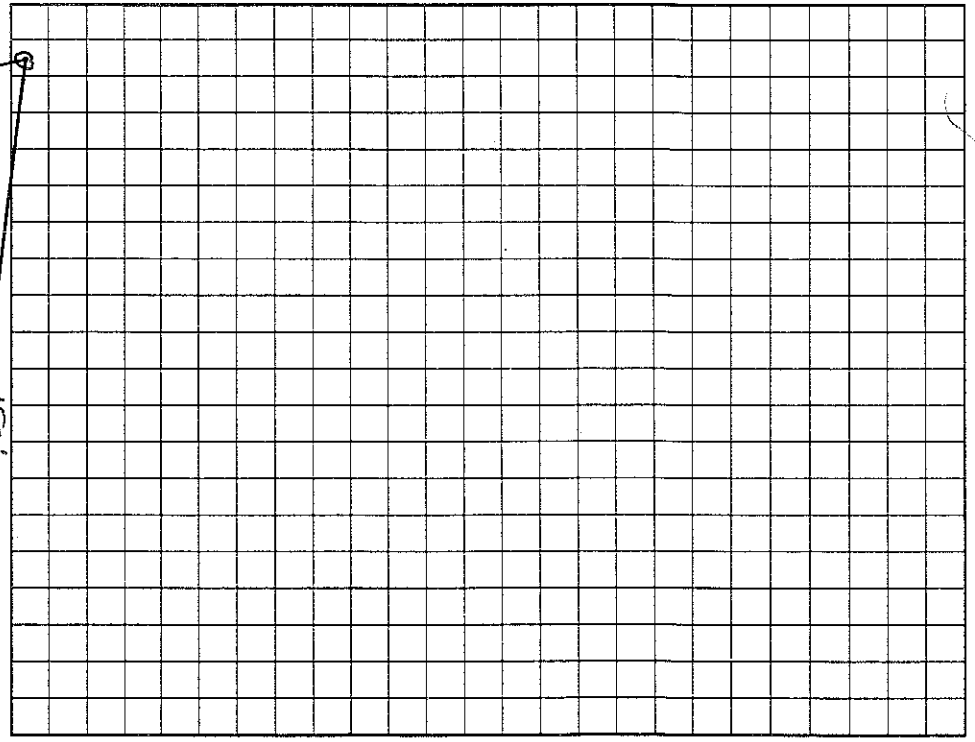

Permit can be suspended or revoked if any false information is supplied toward securing the permit/any unauthorized changes are made to the site/any unauthorized changes are made in the installation of the system. Improvement Permit with ~~plat~~ valid without expiration. Improvement Permit with site plan valid for sixty months. Authorization to Construct is valid for a period equal to that of Improvement Permit – not to exceed sixty months.

Signed: Robert B. Dienst date 9/20/02 Installed by: R & H Inc

Improvement Permit by: [signature] RS date 8/15/02 Operation Permit by: Maria H. Dolan R.S. date 8/27/04

Authorization to Construct by: [signature] RS date 5/11/04 Existing System Inspection by: date

HEALTH DEPT. COPY: WHITE OWNER COPY (FINAL): YELLOW OWNER COPY (INITIAL): PINK