~~ELL~~ COUNTY HEALTH DEPARTMENT ~~STATESVILLE 704-878-5305~~ MOORESVILLE 704-664-5281

IMPROVEMENT PERMIT / ~~CERTIFICATE OF COMPLETION~~ / OPERATION PERMIT / EXISTING SYSTEM INSPECTION

PROPERTY DESCRIPTION NO. 12804 DATE 12/22/95 TAX MAP NO. ~~2K B 87~~ 4646178631 Watershed: ☒ Yes ☐ No

OWNER OR CONTRACTOR Lyle Calhoun PHONE: Business 892-1383 Home

ADDRESS 20468-P Chartwell Center Dr. Davidson, NC 28036

LOCATION Sunset Rd. ~.3 mile on (R) past Lake Vista Dr.

SUBDIVISION Cooper Prop. BLOCK / SECTION LOT 2 LOT AREA .514 SITE CLASS P-5 DESIGN FLOW 360 L.T.A.R. .35

Septic Tank: 1000 Gallons; STB 794 Date 10-18-95
Pump Tank: 1000 Gallons; PT 27 Date 3-10-96
Pump Make: Model Serial No.
Nitrification Field: No Fields 1 Square Feet 1028 Linear Feet 260 (342)
No Lines 3 Trench Width 36" Max Trench Bottom Depth 36" Gravel Depth 6" STONE

☒ New System ☐ Repair System Type: I, II, III, IV, V, VI
System Description: Pump chamber trench
Repair System Description:
Maintenance Agreement Required: ☐ Yes ☐ No


☒ House/Mod. Home No. Bedrooms 3
☐ Mobile Home No. Bathrooms 3
☐ Business No. Employees
☐ Other
☐ Slab ☒ Crawl Space ☐ Basement w/plumbing ☐ Basement wo/plumbing

Water Supply: ☒ Individual ☐ Community ☐ Public


Comments: 25% reduction for use of chamber trench
No more than 6" drawdown per dose of pump

Comments: Lines, Pump, tanks ok Checked on 4/17/96

INITIAL SITE SKETCH

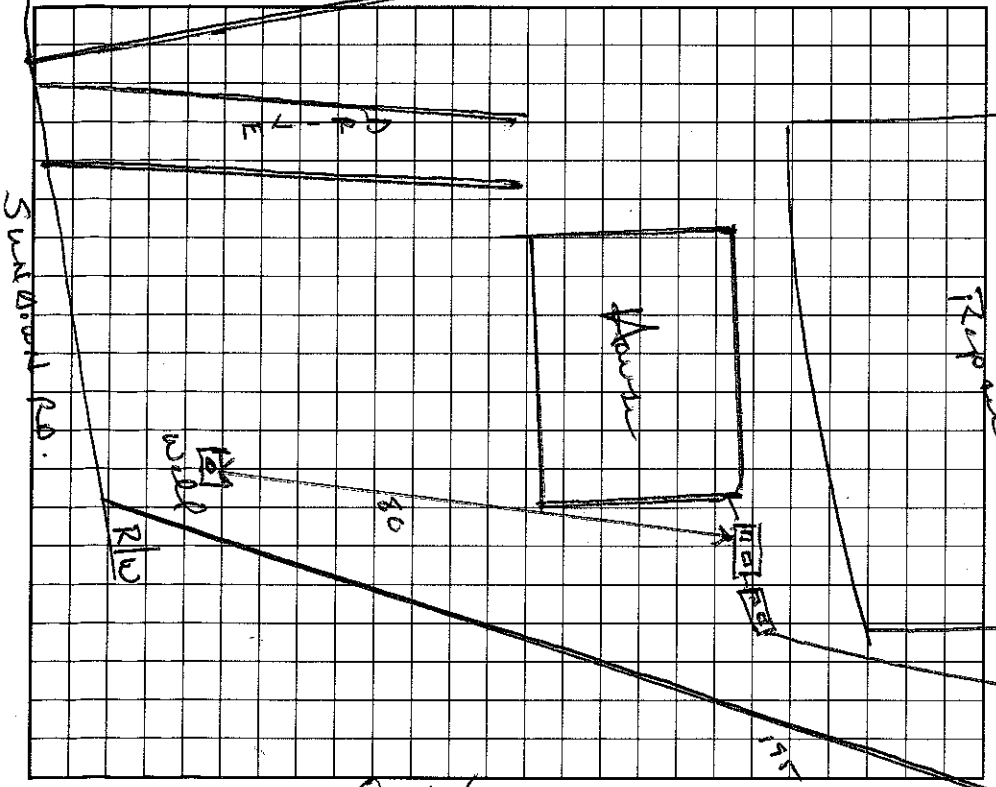

AS BUILT SKETCH

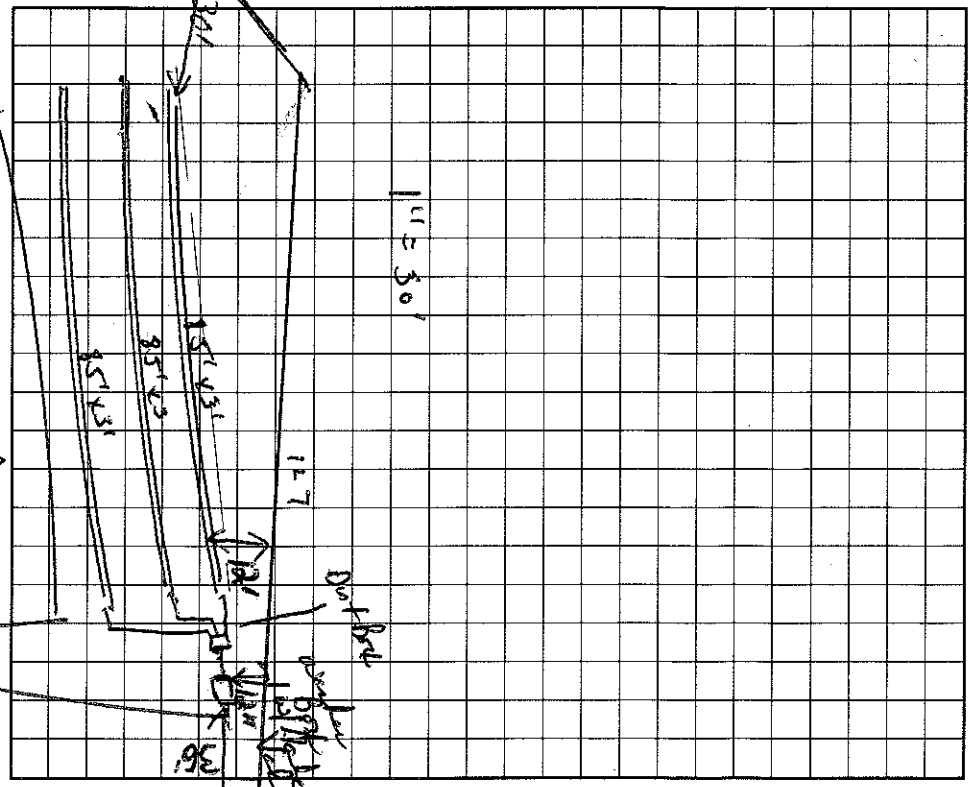

I understand that this permit can be suspended or revoked if any false information is supplied toward securing the permit, any unauthorized changes are made to the site, any unauthorized changes are made in the installation of the system.

Signed: Lyle Calhoun

Improvement Permit by: Wesley Sparks R.S. date 12/22/95

Existing System Inspection by: ~~Sanitarian~~ Wesley Sparks RS date 12/22/95

Installed by: ~~Christopher~~ William Christenberry

Certificate of Completion by: [signature] EHSI date 4/29/96

Operation Permit by: [signature] date 4/29/96

HEALTH DEPT. COPY: WHITE INSPECTION COPY (FINAL): GREEN OWNER COPY (FINAL): YELLOW INSPECTION COPY (INITIAL): PINK OWNER COPY (INITIAL): GOLD