IREDELL COUNTY HEALTH DEPARTMENT

Statesville Phone TR 3-7271 Mooresville Phone NO 3-1271

PERMIT TO INSTALL SEPTIC TANK

Permit NO. _____ Permit Date 23 July 1965

Owner Sam Driscoll Address Mooresville, NC

Installed By Stallo + Blanton. Address Chris Grove NC


Location of Property J. O Atwell Property at end of Rd

Tank		Capacity		Length of Lines		Fixtures	
Block	( )	800	( )	150'	( )	No. of Baths	( )
Precast	(✓)	900	( )	175'	( )	Dishwasher	( )
		1000	(✓)	200'	( )	Garbage Grdr.	( )
		1100	( )	225'	(✓)	Auto-Washer	( )
		1200	( )	250'	( )	Other	
		Other		Other			

NOTIFY HEALTH DEPARTMENT AT LEAST EIGHT HOURS BEFORE TANK IS TO BE INSPECTED.

Final Inspection 23 July 1965 Approved (✓) Disapproved ( )

Remarks Taffolk Deep Hole 6

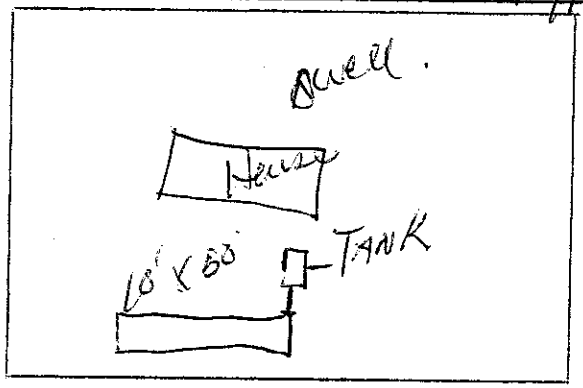

Sketch of Installation

Ray Sowers
Sanitarian