IREDELL COUNTY HEALTH DEPARTMENT

STATESVILLE 704-878-5305 MOORESVILLE 704-664-5281

IMPROVEMENT PERMIT / AUTHORIZATION TO CONSTRUCT / OPERATION PERMIT / EXISTING SYSTEM INSPECTION

PERMIT# 137331 PIN# 4646 17 9043 DATE 5/19/08

OWNER OR APPLICANT Thomas Alleese PHONE: Business 704-658-7655 Home

ADDRESS 385 Sundown Rd. Mooresville, NC. 28117

LOCATION W. Plemson Rd. S TR Sundown Rd. on (L) # 385

SUBDIVISION NA BLOCK / SECTION LOT LOT AREA ~1.4 ac SITE CLASS. P5 DESIGN FLOW 480 L.T.A.R. .3

Septic Tank: 1000 Gallons; STB 784 Date 9/5/07

Pump Tank: 1000 Gallons; PT 283 Date 9/25/07

Pump Make: Goulds Model WEC-511HH Serial No. 4108

Nitrification Field: No Fields 1 Square Feet 1200 Linear Feet 400

No Lines 5@80' Trench Width 3' Max Trench Bottom Depth 3'

☐ New System ☒ Repair ☐ Expansion System Type: I II (III) IV V VI

System Description: PM - IG4W

Repair System Description: SAME

Maintenance Agreement Required: ☐ Yes ☐ No

Gravel Depth NA ☐ Gravity ☑ Pressure

☒ House/Mod. Home ☐ Mobile Home ☐ Business ☐ Other


No. Bedrooms 4 No. Persons No. Employees

Water Supply: ☒ Individual ☐ Public ☐ Community

☐ Slab ☐ Crawl Space ☒ Basement w/plumbing ☐ Basement wo/plumbing


Comments:/Conditions:

INITIAL SITE SKETCH

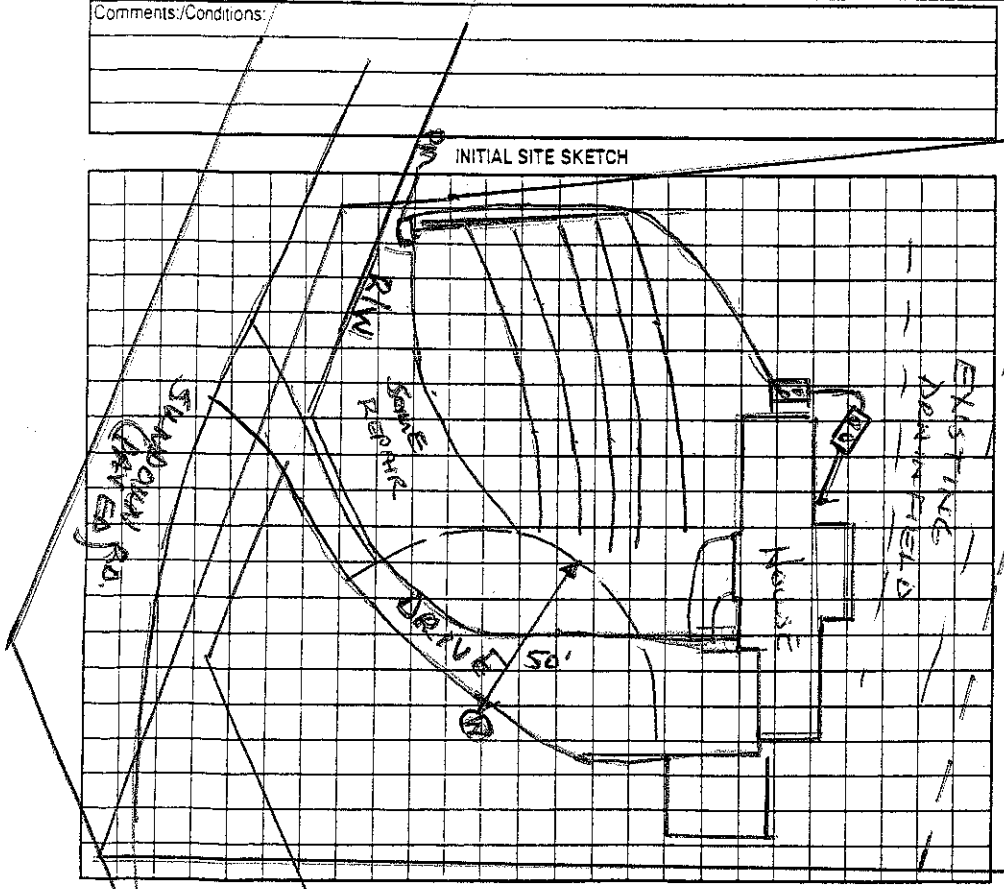

Comments:/Conditions:

AS BUILT SKETCH

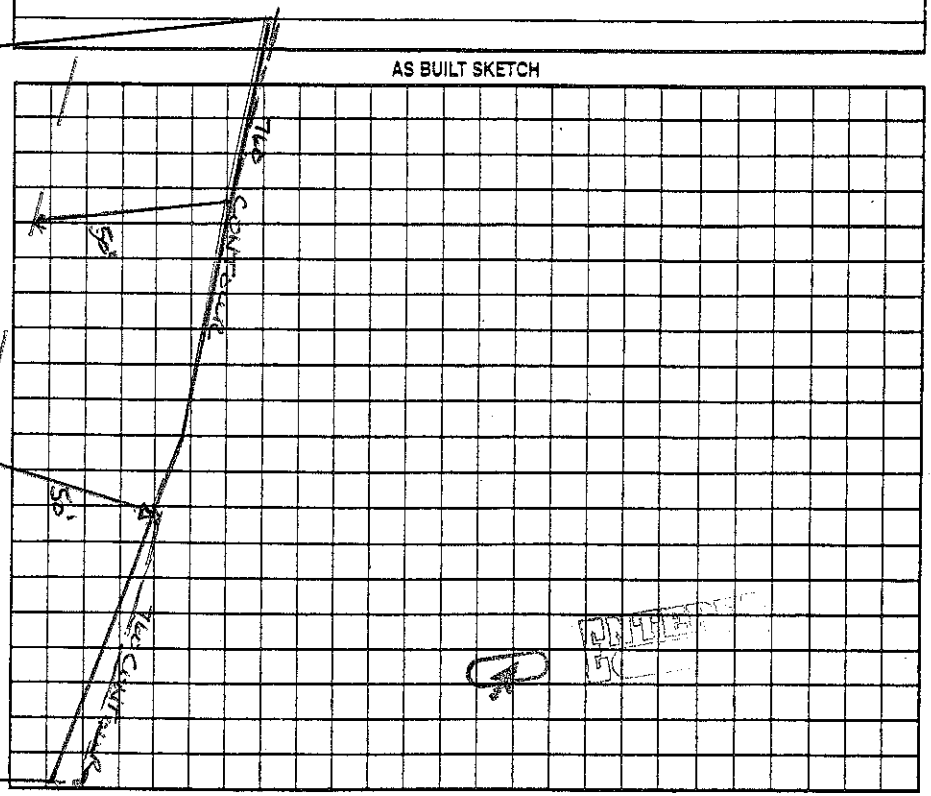

Permit can be suspended or revoked if any false information is supplied toward securing the permit/any unauthorized changes are made to the site/any unauthorized changes are made in the installation of the system. Improvement Permit with plat valid without expiration ☐ Improvement Permit with site plan valid for sixty months ☐ Authorization to Construct is valid for a period equal to that of Improvement Permit – not to exceed sixty months.

Signed: date

Improvement Permit by: date

Authorization to Construct by: date

Installed by: Larry Beam

Operation Permit by: Wesley Sparks RS date 5/19/08

Existing System Inspection by: date

HEALTH DEPT. COPY: WHITE OWNER COPY (FINAL): YELLOW OWNER COPY (INITIAL): PINK