IREDELL COUNTY HEALTH DEPARTMENT

Statesville Office (704) 878-5305 Mooresville Office (704) 660-3625 PERMIT # 210098

IMPROVEMENT PERMIT / AUTHORIZATION TO CONSTRUCT / OPERATION PERMIT / EXISTING SYSTEM

PIN # 4646-17-9291.000

APPLICANT: Johnathan Hassler APPLICANT ADDRESS: 401 Sundown Rd. Mooresville NC

SITE ADDRESS: 401 Sundown Rd. Mooresville NC PHONE: 704-634-9123 ALT. PHONE:

SITE DIRECTIONS: Williamson Rd. to Sundown, Site on L

SUBDIVISION: — SECTION: — LOT # — LOT AREA: 1.4 Acre DESIGN FLOW: Ex. 360 GPD L.T.A.R.: Existing

Septic Tank	Existing	(gal)	STB		Date						
Pump Tank		(gal)	PT		Date						
Pump Make		Model			Serial #						
# Nitrification Fields	Ex.	# Lines	Ex. 3		Linear Ft:	Ex.					
Trench Width	Ex.	Max. Trench Bottom Depth	Existing		Gravel Depth	Existing					

☐ New System ☐ Repair ☐ Expansion System Type: I (II) III IV V VI

System Description: Existing Gravity Conventional

Repair System Description: Existing

Maintenance Agreement Required: ☐ YES ☒ NO

☒ GRAVITY ☐ PRESSURE

☒ Residence ☐ Business ☐ Other ☐ Slab ☒ Basement w/plumbing ☐ Crawl Space ☐ Basement w/o plumbing

No. Bedrooms Ex. 3 No. Persons Ex. 6 No. Employees

Water Supply: ☒ Private ☐ Public ☐ Community


Comments / Conditions: System Appeared To Be Functioning At Time Of Inspection. Maintain 5' Separation From Septic System With Deck/Laundry Room Addition.

INITIAL SITE SKETCH

1" = 50'

154'

AS BUILT SKETCH

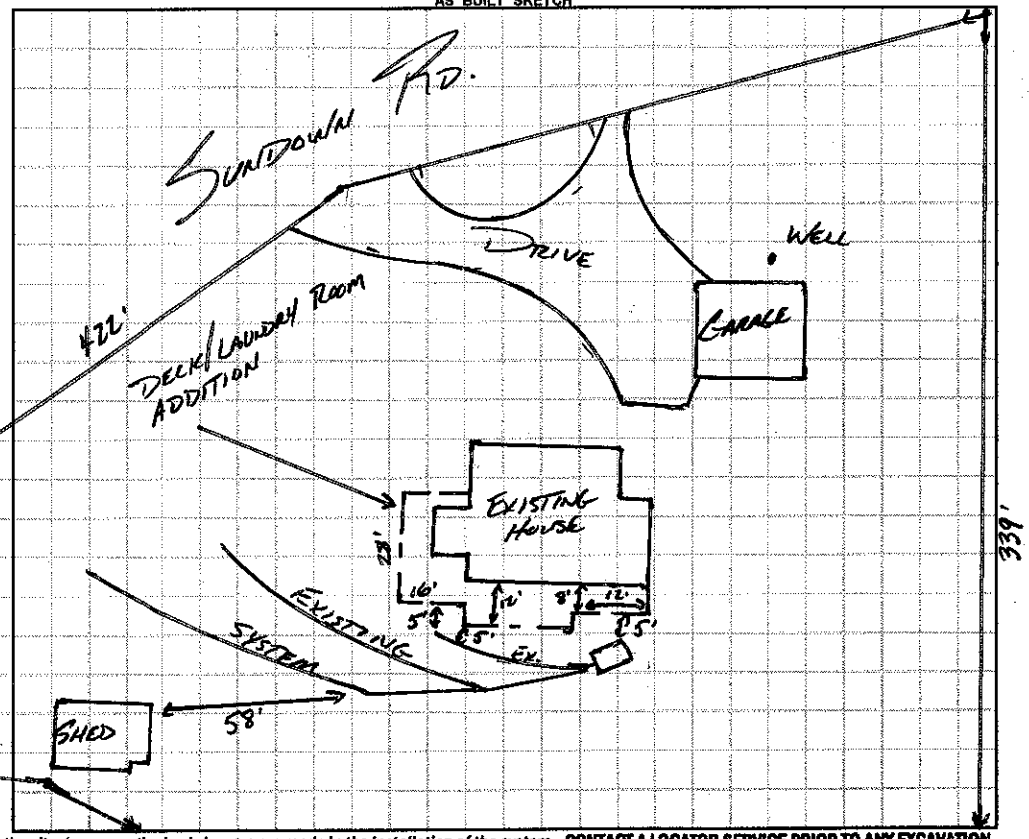

Permit can be suspended or revoked if any false information is supplied toward securing the permit / any unauthorized changes are made to the site / any unauthorized changes are made in the installation of the system. **CONTACT A LOCATOR SERVICE PRIOR TO ANY EXCAVATION**

☐ **IMPROVEMENT PERMIT** *with plat valid without expiration.* ☐ **IMPROVEMENT PERMIT** *with site plan valid for 60 mos.* ☐ **AUTHORIZATION TO CONSTRUCT** *valid for period equal to IMPROVEMENT PERMIT--not to exceed 60 mo.*

LAKE

Owner / Applicant Signature: Date: Installed by:

IMPROVEMENT PERMIT by: Date: 5/29/16 OPERATION PERMIT by: Date:

AUTHORIZATION TO CONSTRUCT by: Date: Existing System Inspected by: APPROVED Date MAY 29 2016

Health Dept. Copy - WHITE Applicant (Final Approval) - YELLOW Applicant (Conditional Approval) - PINK