IREDELL COUNTY HEALTH DEPARTMENT

STATESVILLE 704-878-5305 MOORESVILLE 704-664-5281

IMPROVEMENT PERMIT / CERTIFICATE OF COMPLETION / OPERATION PERMIT / EXISTING SYSTEM INSPECTION

PROPERTY DESCRIPTION NO. 16761 DATE August 17, '93 TAX MAP NO. 2K-7A 18

OWNER OR CONTRACTOR William & Kim Kenyon PHONE: Business _____ Home 464618 1840

ADDRESS _____

LOCATION 1100 TR 1179 TR Regency DR. - to end, TR Hazelton RS ~ 50' on left

SUBDIVISION Regency Lake BLOCK / SECTION _____ LOT 18 LOT AREA 100' x ~246' SITE CLASS. RS L.T.A.R. .3

Water Supply: ☐ Individual ☑ Community ☐ Public

Septic Tank: 1000 Gallons; STB 794 Dellinger Date 11-29-93

Pump Tank: 1000 Gallons; PT 27 Dellinger Date 3-4-94

Nitrification Field: No Fields 1 Square Feet 200 Linear Feet 400

No Lines 5 Trench Width 36" Trench Depth 24" Gravel Depth 12"

☑ New System ☐ Repair System Type: I, II, III, IV, V, VI

System Description: Pumped conventional

Repair System Description: LP PPBS

Maintenance Agreement Required: ☐ Yes ☒ No

☑ House/Mod. Home ☐ Mobile Home ☐ Business ☐ Other

No. Bedrooms 3 No. Bathrooms 2 No. Employees _____

Garbage Disposal: ☐ Yes ☑ No

Auto. Dishwasher: ☑ Yes ☐ No


Auto. Washing Machine: ☑ Yes ☐ No

Other _____


☐ Slab ☐ Crawl Space ☑ Basement w/plumbing ☐ Basement wo/plumbing

Comments: This permit replaces permit issued 8/12/93. Note trench bottom depth. 200 gal/foot at ~ 7 minute cycle.

INITIAL SITE SKETCH

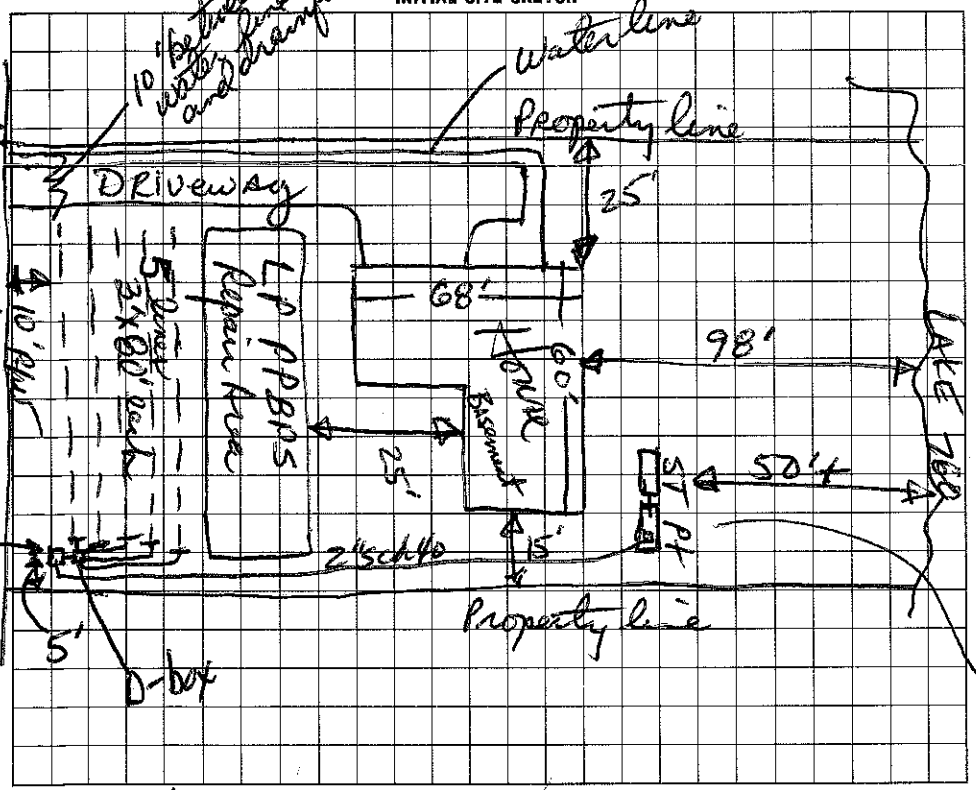

AS BUILT SKETCH

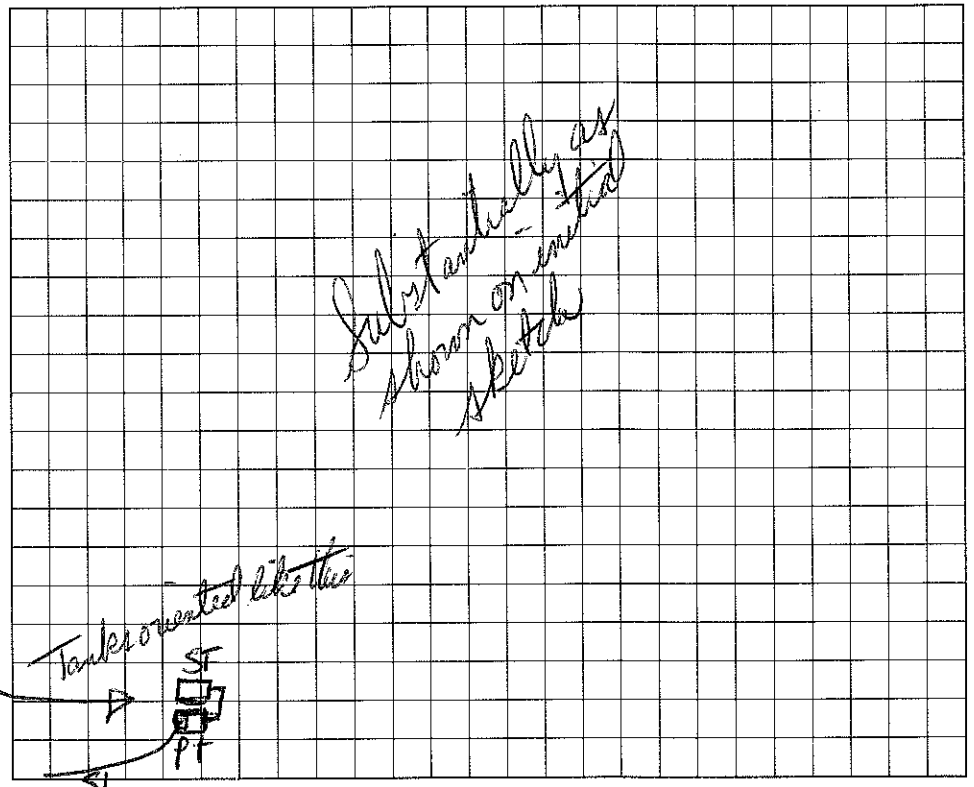

I understand that this permit can be suspended or revoked if any false information is supplied toward securing the permit/any unauthorized changes are made to the site/any unauthorized changes are made in the installation of the system. Improvement Permit is valid for 60 months from date of issuance.

Signed: _____

Improvement Permit by: Jerry D. Harrison, RS date 8/17/93

Existing System Inspection by: _____ date _____

Installed by: Jerry Beam

Certificate of Completion by: _____ date _____

Operation Permit by: Jerry D. Harrison, RS date 6/23/94

HEALTH DEPT. COPY: WHITE INSPECTION COPY (FINAL): GREEN OWNER COPY (FINAL): YELLOW INSPECTION COPY (INITIAL): PINK OWNER COPY (INITIAL): GOLD