(1)

IREDELL COUNTY HEALTH DEPARTMENT

STATESVILLE 704-878-5305 MOORESVILLE 704-884-5281

IMPROVEMENT PERMIT / CERTIFICATE OF COMPLETION / OPERATION PERMIT / EXISTING SYSTEM INSPECTION

PROPERTY DESCRIPTION NO. 16761

OWNER OR CONTRACTOR William & Kim Kenyon DATE August 17 '93 TAX MAP NO 2K-7A 18

ADDRESS PHONE: Business Home

LOCATION 1100 TL 1179 TL Regency DR. to end, TR Hazelton, ~50' on left

SUBDIVISION Regency Lake BLOCK / SECTION 1 LOT 18 LOT AREA 100' x ~246' SITE CLASS. B L.T.A.R. .3

Water Supply: ☐ Individual ☑ Community ☐ Public

Septic Tank: 1000 Gallons: STD 794 Delivered Date 11-29-93

Pump Tank: 1000 Gallons: PT 27 Delivered Date 3-4-94

Nitrification Field: No. Fields 1 Square Feet 1200 Linear Feet 400

No Lines 5 Trench Width 36" Trench Depth 24" Gravel Depth 12"

☑ New System ☐ Repair System Type: I II (III) IV V VI

System Description: Pumped Conventional

Repair System Description: LP PPBPS

Maintenance Agreement Required: ☐ Yes ☐ No

☑ House/Mod. Home No. Bedrooms 3 Garbage Disposal ☐ Yes ☑ No

☐ Mobile Home No. Bathrooms 2 Auto. Dishwasher: ☑ Yes ☐ No


☐ Business No. Employees Auto Washing Machine ☑ Yes ☐ No

☐ Other Other


☐ Slab ☐ Crawl Space ☑ Basement w/plumbing ☐ Basement wo/plumbing

Comments: This permit replaces permit issued 8/12/93. Note trench bottom depth, 200 gal dose at ~7 min cycle.

INITIAL SITE SKETCH

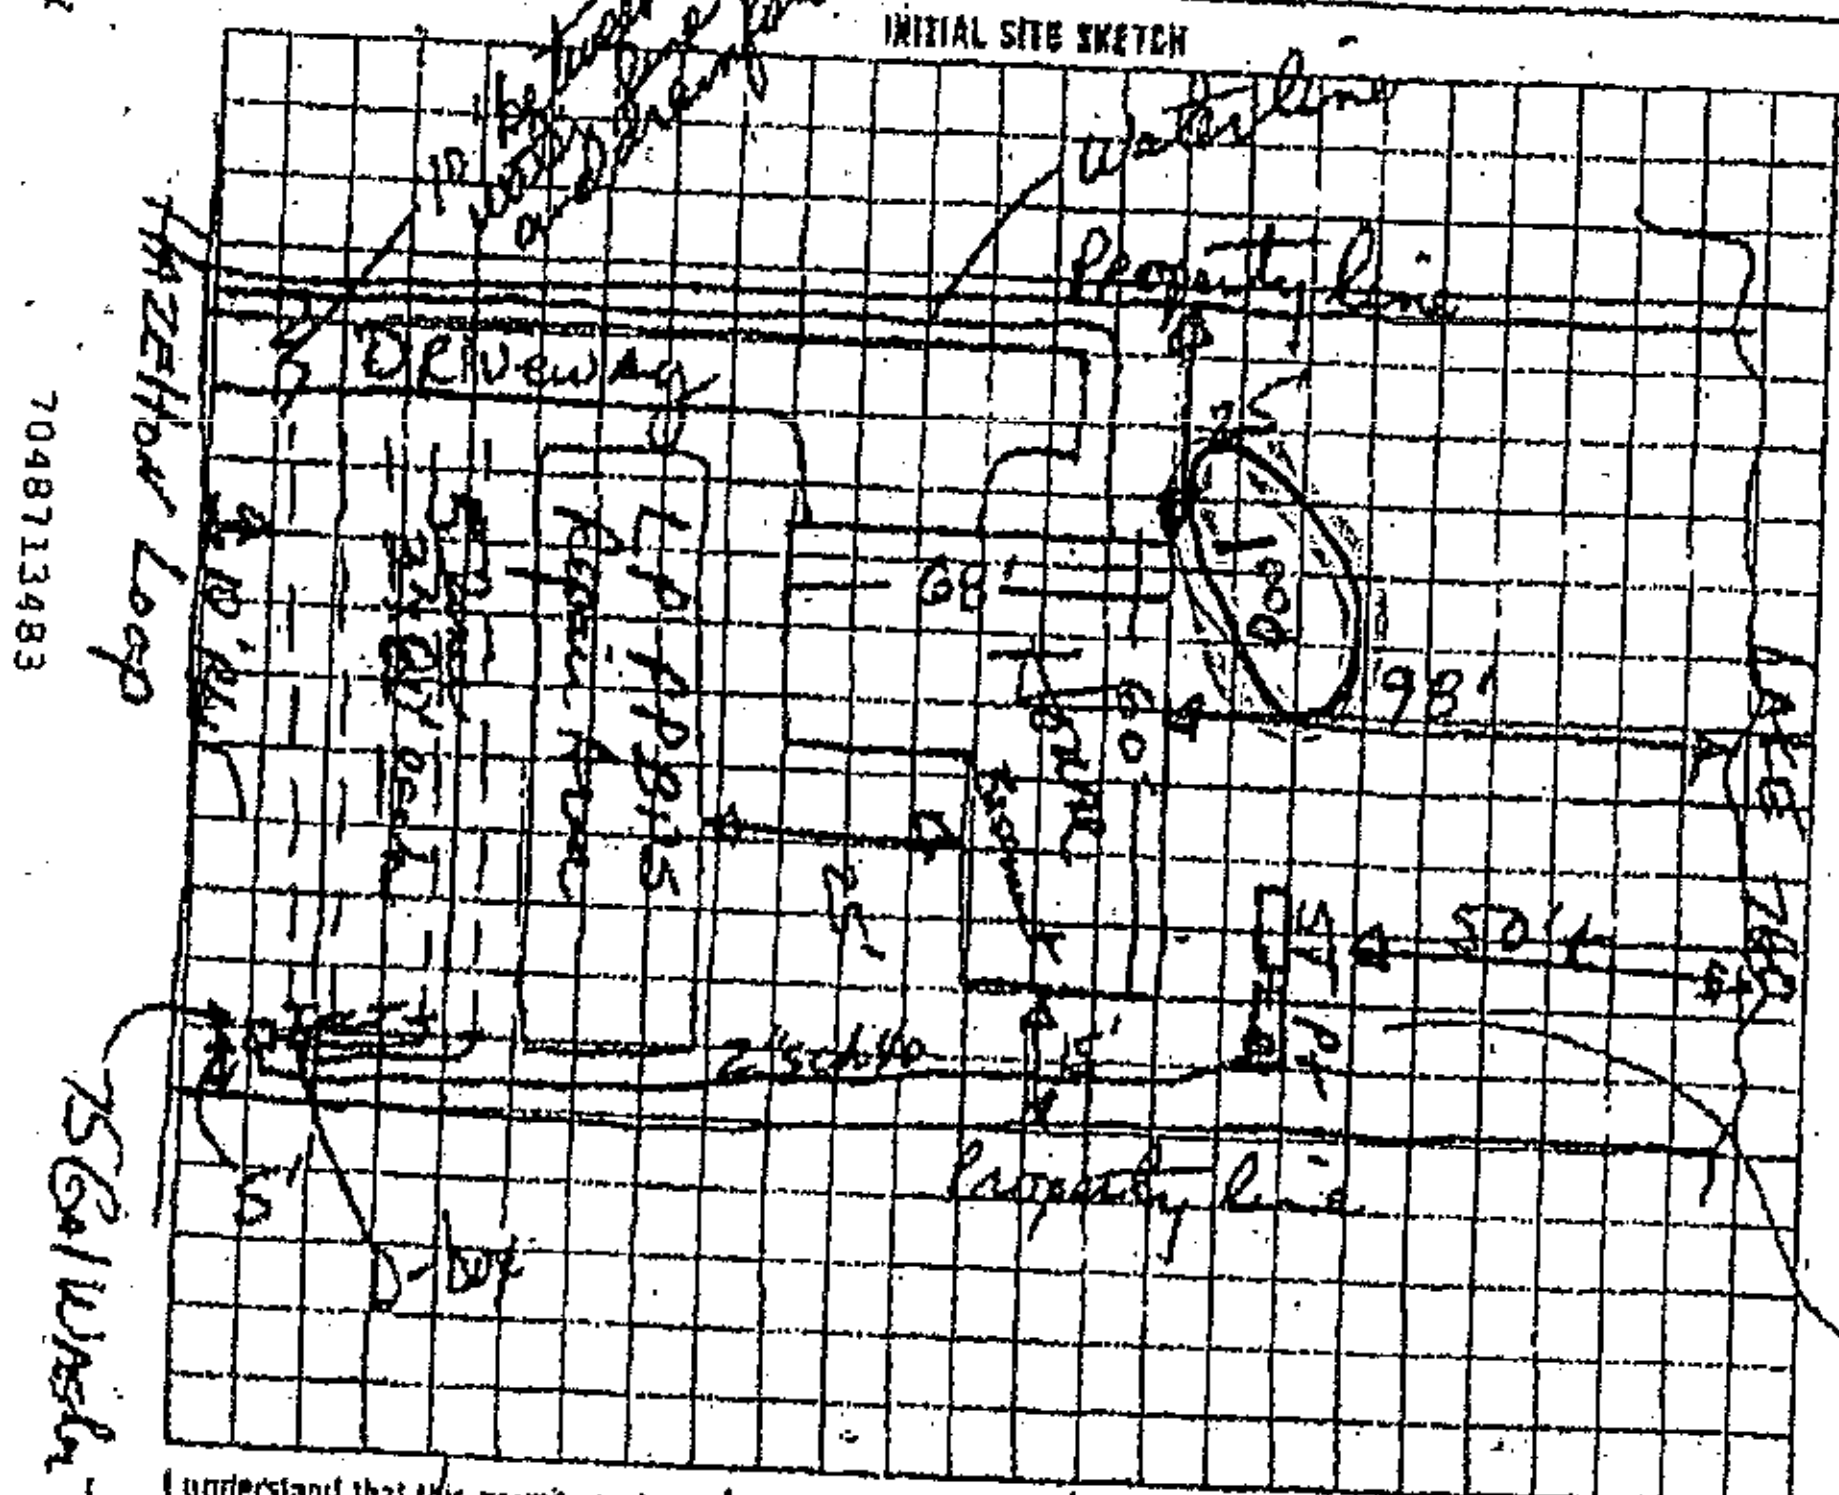

AS BUILT SKETCH

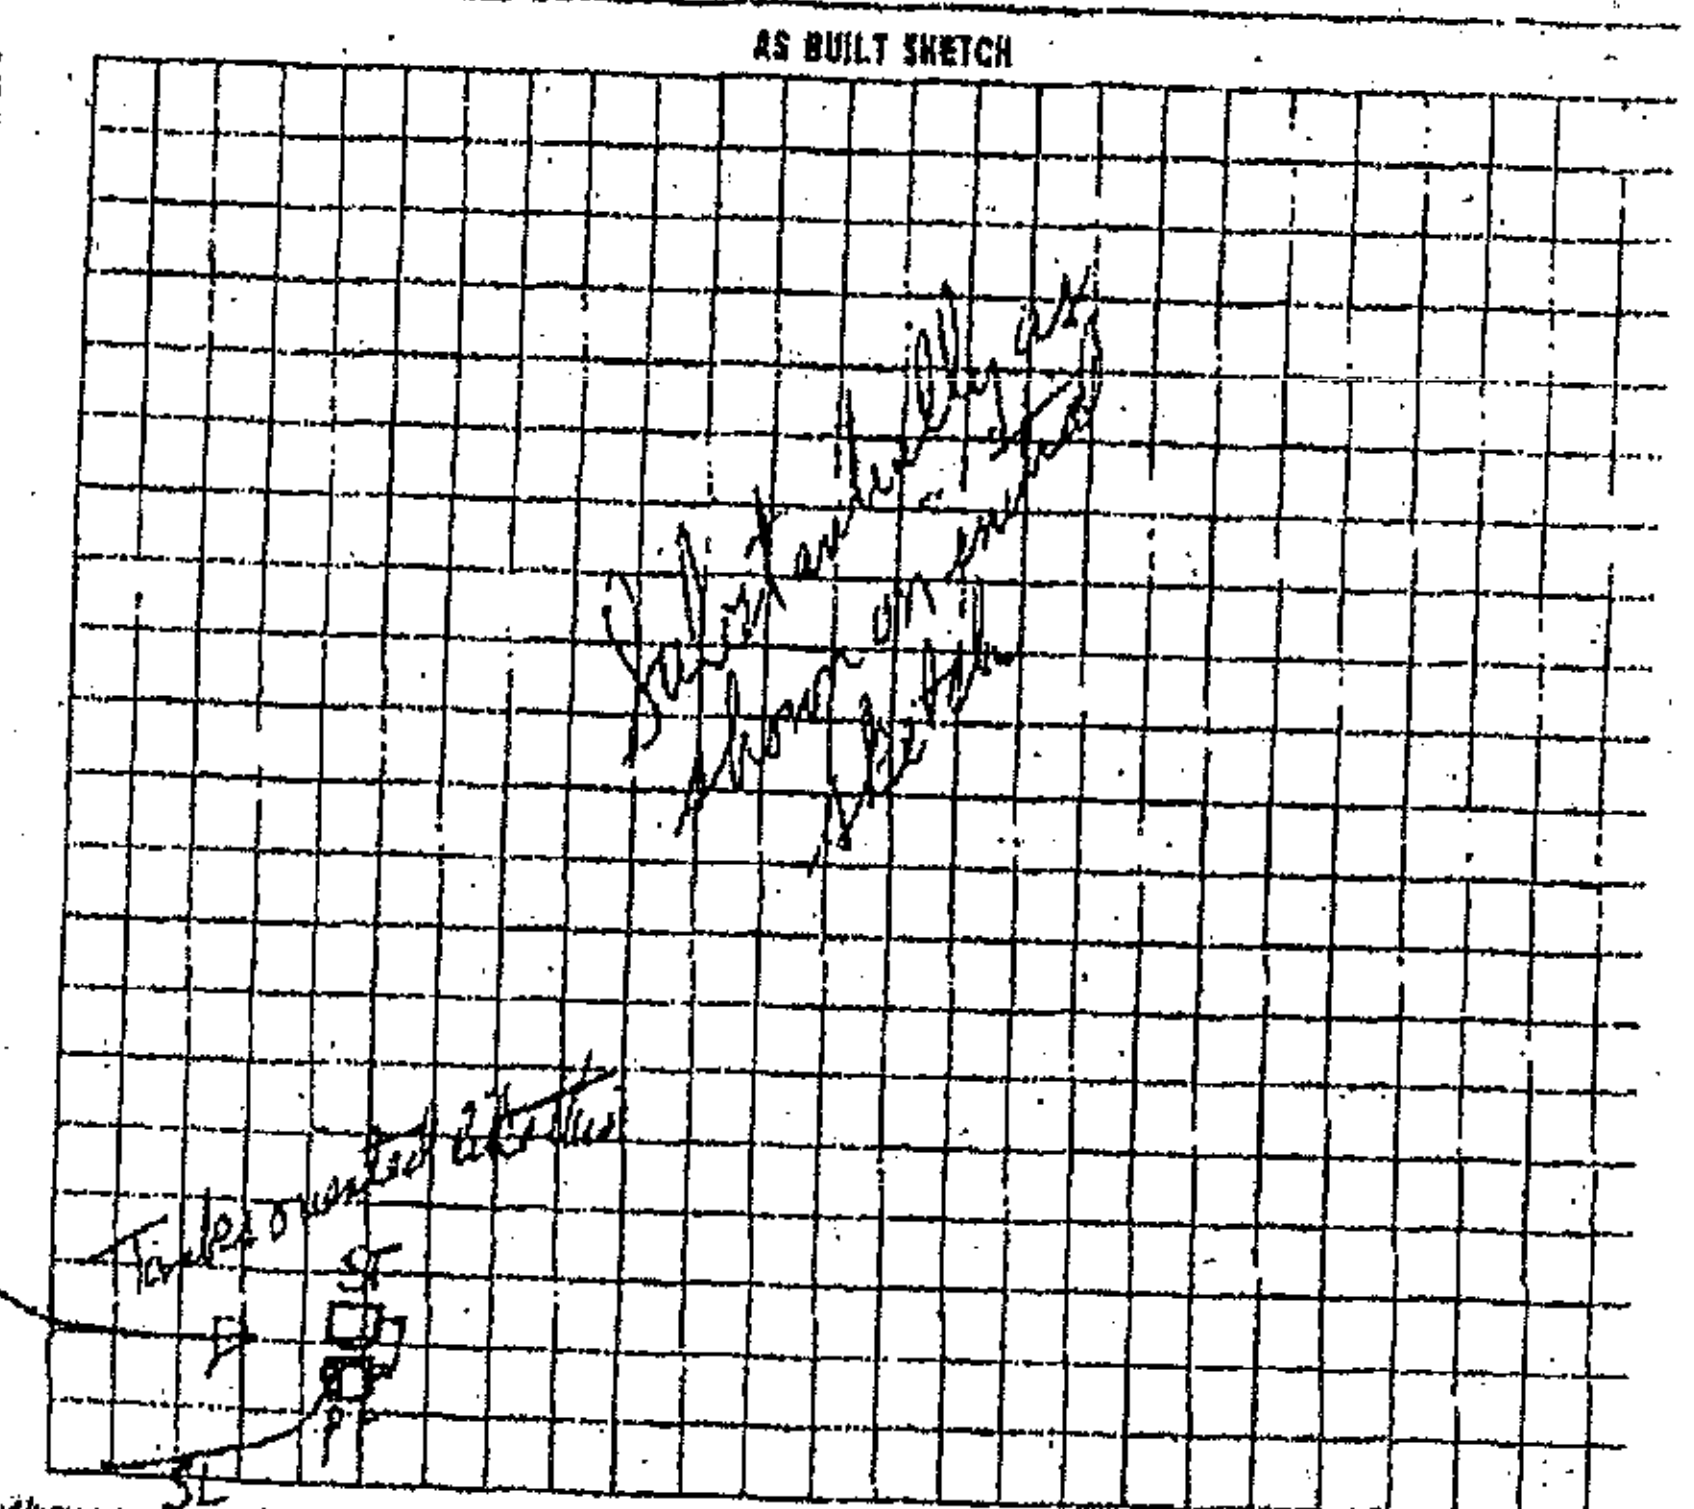

I understand that this permit can be suspended or revoked if any false information is supplied toward securing the permit/any unauthorized changes are made to the site/any unauthorized changes are made in the installation of the system. Improvement Permit is valid for 60 months from date of issuance.

Signed: Kim A. Kenyon

Improvement Permit by: David L. Hinson RS date 8/17/93

Installed by: Jerry Beam

Certificate of Completion by: date