IREDELL COUNTY HEALTH DEPARTMENT

STATESVILLE 704-878-5305 MOORESVILLE 704-664-5281

IMPROVEMENT PERMIT / AUTHORIZATION TO CONSTRUCT / OPERATION PERMIT / EXISTING SYSTEM

PERMIT# 06 8929 PIN# 4646 18 1859 DATE 1/10/00

OWNER OR CONTRACTOR Young Homes Inc. PHONE: Business 370-7710 Home

ADDRESS 1043 E. Morehead St. Suite 200 Charlotte, NC. 28204

LOCATION 1100 TL Concord Church TL Regency to stop sign X road straight ahead.

SUBDIVISION REGENCY LAKE VILLAGE / SECTION LOT 19 LOT AREA .532 AC SITE CLASS: PS DESIGN FLOW 360 L.T.A.R. .3

Septic Tank: 1000 Gallons; STB 794 Date 2/29/00
Pump Tank: 1000 Gallons; PT 27 Date 9/2/00
Pump Make: GOULDS Model WSC-3HM Serial No. 2-2-00
Nitrification Field: No Fields 1 Square Feet *630 Linear Feet *210
No Lines 3 Trench Width 36" Max Trench Bottom Depth 36" Gravel Depth SAND.

[X] New System [ ] Repair System Type: I, II, (III), IV, V, VI
System Description: 16" PBS - PRES. MANIFOLD
Repair System Description: SAME
Maintenance Agreement Required: [ ] Yes [X] No


[X] House/Mod. Home No. Bedrooms 3
[ ] Mobile Home No. Bathrooms 2.5
[ ] Business No. Employees
[ ] Other
[ ] Slab [ ] Crawl Space [X] Basement w/plumbing [ ] Basement w/o plumbing

Water Supply: [ ] Individual [ ] Public [X] Community


Comments:

Comments:

INITIAL SITE SKETCH

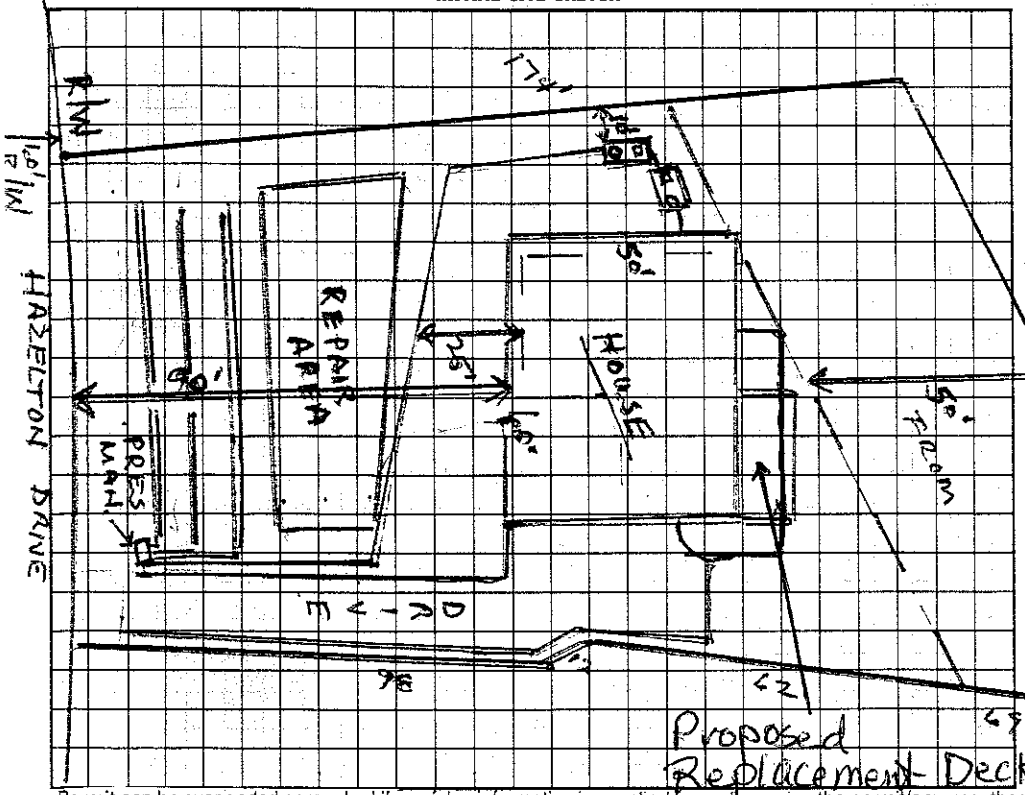

AS BUILT SKETCH

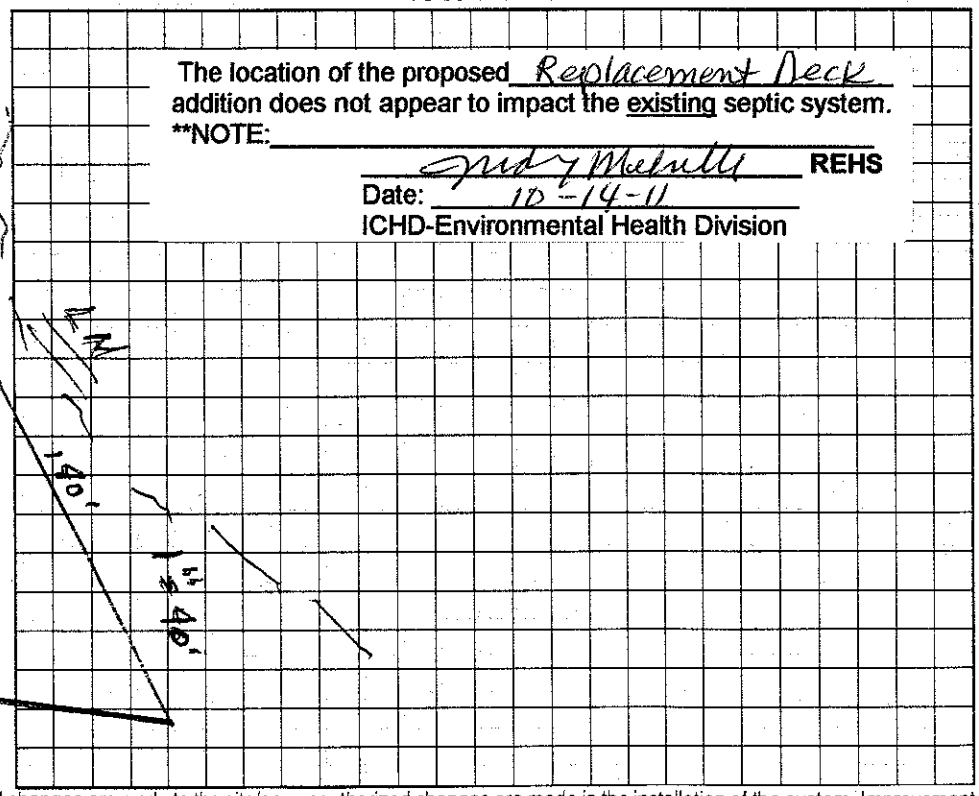

The location of the proposed Replacement Deck addition does not appear to impact the existing septic system.
**NOTE:

Judy Melville REHS
Date: 10-14-11
ICHD-Environmental Health Division

Permit can be suspended or revoked if any false information is supplied toward securing the permit/any unauthorized changes are made to the site/any unauthorized changes are made in the installation of the system. Improvement Permit with plat valid without expiration. Improvement Permit with site plan valid for sixty months. Authorization to Construct is valid for a period equal to that of Improvement Permit – not to exceed sixty months.

Signed: Jessica S. Wolfe date 1/11/00 Installed by: Bob McCarver

Improvement Permit by: Wesley Sparks RS. date 1/10/00 Operation Permit by: [signature] RS date 5/18/00

Authorization to Construct by: Wesley Sparks RS. date 1/10/00 Existing System Inspection by: date

HEALTH DEPT. COPY: WHITE OWNER COPY (FINAL): YELLOW OWNER COPY (INITIAL): PINK