IREDELL COUNTY HEALTH DEPARTMENT

STATESVILLE 704-878-5305 MOORESVILLE 704-664-5281

IMPROVEMENT PERMIT / AUTHORIZATION TO CONSTRUCT / OPERATION PERMIT / EXISTING SYSTEM INSPE

PERMIT# 10615 PIN# ~~4646204611.24~~ 4646185567 DATE 8/21/02

OWNER OR CONTRACTOR DIENST ENTERPRISES / RONALD TORPAK PHONE: Business 309-0123 Home

ADDRESS 19315 W CATAWBA AVE SUITE 200 CORNELIUS NC 28031

LOCATION WILLIAMSON - TR SUNDOWN - TR SUNDOWN COVE - LOT DIRECTLY ACROSS STREET AT END OF ROAD

SUBDIVISION ESTATES @ SUNDOWN BLOCK / SECTION LOT 21 LOT AREA 37089 ft² SITE CLASS. RS DESIGN FLOW 480GPD L.T.A.R. .256 FT²

Septic Tank: 1000 Gallons; STB 312 Date 12/29/04
Pump Tank: 1000 Gallons; PT 27 Date 10/23/04
Pump Make: Goulds Model WE0712M Serial No.
Nitrification Field: No Fields 1 Square Feet 640 Linear Feet 300
No Lines 6 Trench Width 24" Max Trench Bottom Depth 36" Gravel Depth N/A

☑ New System ☐ Repair System Type: I, II, III, IV, V, VI
System Description: LP PANEL
Repair System Description: SAME OFFSITE
Maintenance Agreement Required: ☑ Yes ☐ No
☐ Slab ☐ Crawl Space ☑ Basement w/plumbing ☐ Basement wo/plumbing


☑ House/Mod. Home No. Bedrooms 4
☐ Mobile Home No. Bathrooms 4
☐ Business No. Employees
☐ Other

Water Supply:
☐ Individual
☐ Public
☑ Community


Comments:/Conditions: 1) SEE MASTER PLAT FOR PUMP SUPPLY LINE RUNS TO REPAIR AREA
2) INLINE PUMP FILTER TO BE INSTALLED

Comments:/Conditions: PARTIAL
- KEEP TANKS 15' DOWNSLOPE FROM POOL
- SWITCH DRIVE TO OTHER SIDE

INITIAL SITE SKETCH

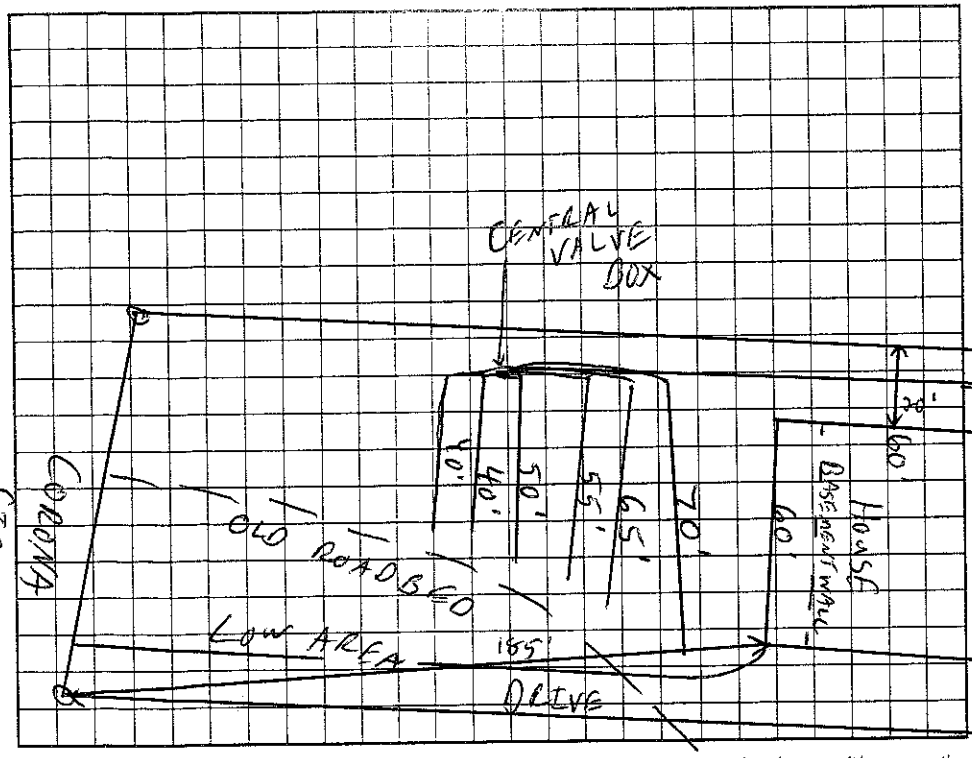

AS BUILT SKETCH

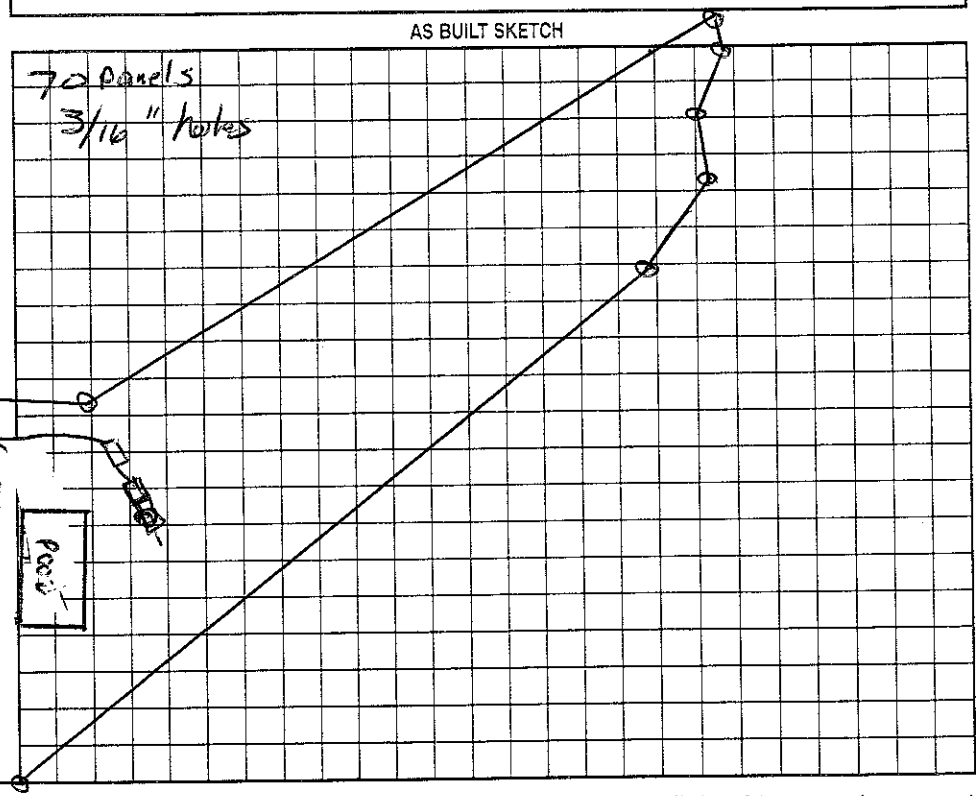

Permit can be suspended or revoked if any false information is supplied toward securing the permit/any unauthorized changes are made to the site/any unauthorized changes are made in the installation of the system. Improvement Permit with plat valid without expiration. Improvement ~~Permit~~ with site plan valid for sixty months. Authorization to Construct is valid for a period equal to that of Improvement Permit – not to exceed sixty months.

Signed: Robert B. Dienst date 9/20/02
KS date 8/21/02
KS date 6/8/04

Installed by: E+S Plumbing
Operation Permit by: RS date 3/7/05
Existing System Inspection by: date

OWNER COPY (FINAL): YELLOW OWNER COPY (INITIAL): PINK