IREDELL COUNTY HEALTH DEPARTMENT

STATESVILLE 704-878-5305 MOORESVILLE 704-664-5281

IMPROVEMENT PERMIT / AUTHORIZATION TO CONSTRUCT / OPERATION PERMIT / EXISTING SYSTEM INSPECTION

PERMIT# 106161 PIN# ~~4646 20 46 11 22~~ 4646185682 DATE 10/31/02

OWNER OR CONTRACTOR DIENST ENTERPRISES / Ryan Hom PHONE: Business 309-0123 Home

ADDRESS 19315 W. CATAWBA AVE SUITE 300 CORNELIUS NC 28031

LOCATION WILLIAMSON - TR SUNDOWN - TR SUNDOWN COVE - TR 2nd CORONA -

SUBDIVISION ESTATES @ SUNDOWN BLOCK / SECTION LOT 22 LOT AREA 36198 SITE CLASS. PS DESIGN FLOW 480GPD L.T.A.R. .2670/FCL

Septic Tank: 1000 Gallons; STB 312 Date

Pump Tank: 1000 Gallons; PT 283 Date 7-15-03

Pump Make: Model Serial No.

Nitrification Field: No Fields 1 Square Feet ~~1200~~ 1230 Linear Feet 410

No Lines 8 Trench Width 24" Max Trench Bottom Depth 30" Gravel Depth N/A

☑ New System ☐ Repair System Type: I, II, III, IV, V, VI

System Description: CP ~~REPAIR~~ 25% REDUCTION

Repair System Description: ~~SAME~~ LP PANEL OFFSITE

Maintenance Agreement Required: ☑ Yes ☐ No

☐ House/Mod. Home No. Bedrooms 4

☐ Mobile Home No. Bathrooms 4

☐ Business No. Employees

☐ Other


☐ Slab ☑ Crawl Space ☐ Basement w/plumbing ☐ Basement wo/plumbing

Water Supply: ☐ Individual ☐ Public ☑ ~~Community~~


Comments/Conditions: 1) VALVES IN BOX TO BE NUMBERED. #1 TO BE UPPER LINE & #8 TO BE LOWER LINE. 2) SEE PLAT FOR OFFSITE EASEMENT FOR REPAIR

Comments/Conditions: Tanks & lines checked 8/19/03 SYTEM TO BE LOW PRESSURE 25% REDUCTION Pres. alert & alarm 8/26/03

INITIAL SITE SKETCH 1" = 50'

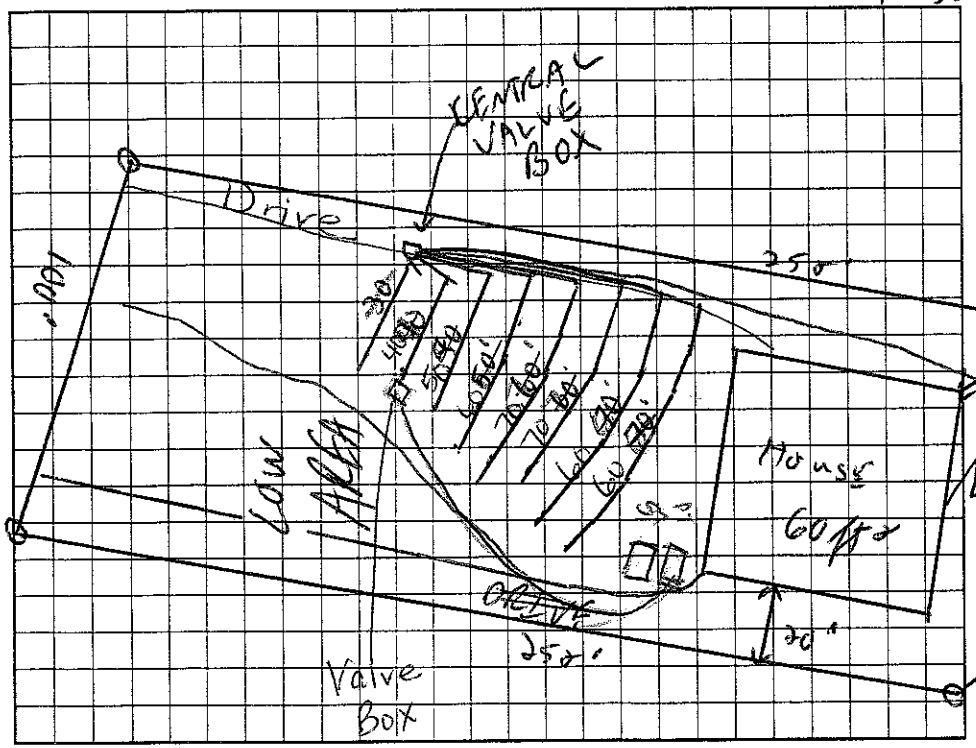

AS BUILT SKETCH

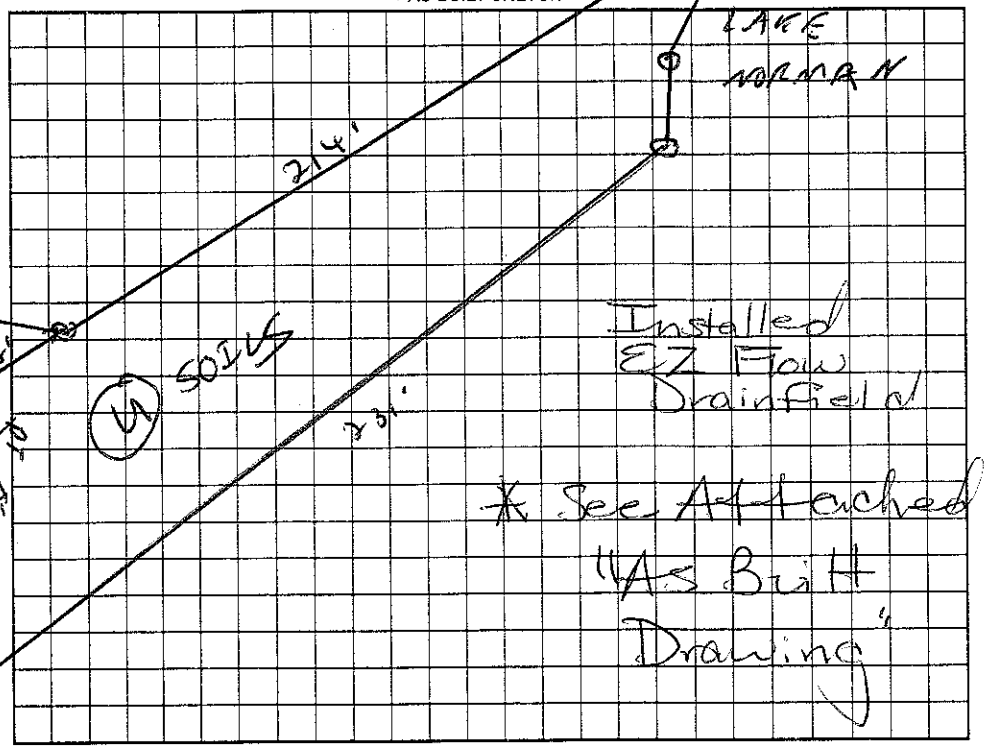

Permit can be suspended or revoked if any false information is supplied toward securing the permit/any unauthorized changes are made to the site/any unauthorized changes are made in the installation of the system. Improvement Permit with plat valid without expiration. Improvement Permit with site plan valid for sixty months. Authorization to Construct is valid for a period equal to that of Improvement Permit – not to exceed sixty months.

Signed: Robert B. Dienst date 11/27/02 Installed by: R & H Inc

Improvement Permit by: C. [illegible] RS date 10/31/02 Operation Permit by: Mark H. Tolson R.S. date 8/26/03

Authorization to Construct by: Wesley Parks R.S. date 3/6/03 Existing System Inspection by: date

HEALTH DEPT. COPY: WHITE OWNER COPY (FINAL): YELLOW OWNER COPY (INITIAL): PINK