Called in 12/22/03 4:00

IREDELL COUNTY HEALTH DEPARTMENT

STATESVILLE 704-878-5305 MOORESVILLE 704-664-5281

IMPROVEMENT PERMIT / AUTHORIZATION TO CONSTRUCT / OPERATION PERMIT / EXISTING SYSTEM INSPECTION

PERMIT# ~~1991~~ 106160 PIN# 4646 20 46 11. 23 4646185792 DATE 8/28/02

OWNER OR CONTRACTOR DIERST ENTERPRISES / RYAN HOMES PHONE: Business 309-0123 Home

ADDRESS 19315 W. CATAWBA AVE. CORNELIUS /

LOCATION WILLIAMSON - TR SUNDOWN - TR SUNDOWN COVE - TR 2nd CORONA - ON LT 243 CORONA CIR.

SUBDIVISION ESTATES @ SUNDOWN BLOCK / SECTION 2 LOT 23 LOT AREA 37583 ft² SITE CLASS. PS DESIGN FLOW 480GPD L.T.A.R. .30 GPD/Ft²

Septic Tank: 1000 Gallons; STB 794 Date 10-16-03
Pump Tank: 1000 Gallons; PT 27 Date 11-4-03
Pump Make: _____ Model _____ Serial No. _____
Nitrification Field: No Fields 1 Square Feet 1200 Linear Feet 400
No Lines 4@100' Trench Width 36" Max Trench Bottom Depth 36" Gravel Depth N/A

☑ New System ☐ Repair System Type: I, II, III, IV, V, VI
System Description: PUMP 25% REDUCTION
Repair System Description: LP PANEL
Maintenance Agreement Required: ☐ Yes ☑ No

☑ House/Mod. Home No. Bedrooms 4
☐ Mobile Home No. Bathrooms 4
☐ Business No. Employees _____
☐ Other _____


☐ Slab ☐ Crawl Space ☑ Basement w/plumbing ☐ Basement wo/plumbing

Water Supply: ☐ Individual ☐ Public ☑ Community


Comments/Conditions: 1) SEE PLAT FOR PUMP RUNS AND EASEMENT AREA.
~~SWRTP~~
2)

Comments/Conditions:
OFFSITE
Checked tanks 12/12/03 MS
Checked lines 12/19/03 MS
E2 FLOW INSTALLED

INITIAL SITE SKETCH

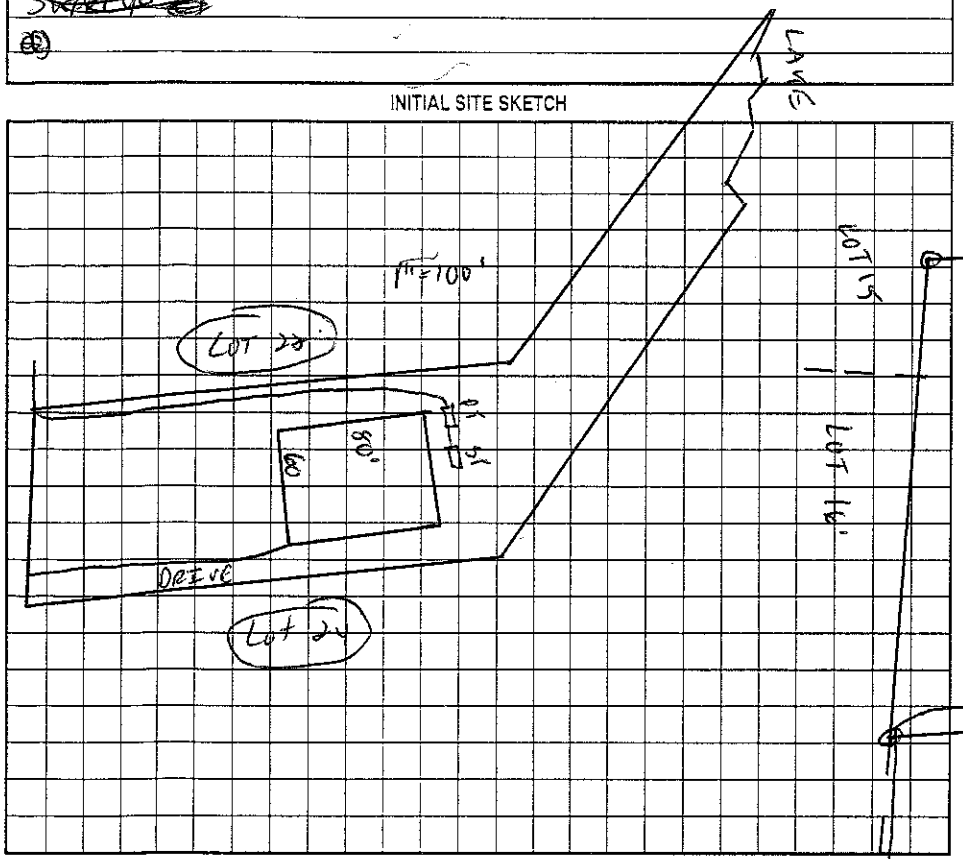

AS BUILT SKETCH

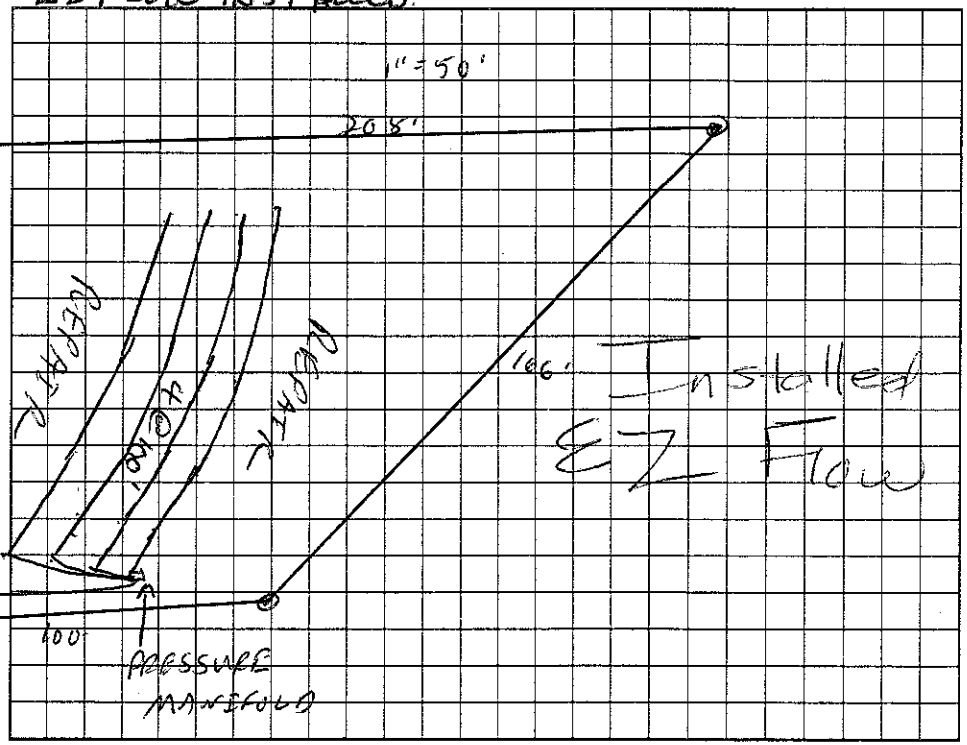

Permit can be suspended or revoked if any false information is supplied toward securing the permit/any unauthorized changes are made to the site/any unauthorized changes are made in the installation of the system. Improvement Permit with plat valid without expiration. Improvement Permit with site plan valid for sixty months. Authorization to Construct is valid for a period equal to that of Improvement Permit – not to exceed sixty months.

Signed: Robert B. Dierst date 9/20/02
Improvement Permit by: C. Hall RS date 8/28/02
Authorization to Construct by: C. Hall RS date 7/16/03

Installed by: R & H
Operation Permit by: Wesley Sparks R.S. date 12/22/03
Existing System Inspection by: _____ date _____

HEALTH DEPT. COPY: WHITE OWNER COPY (FINAL): YELLOW OWNER COPY (INITIAL): PINK