IREDELL COUNTY HEALTH DEPARTMENT

STATESVILLE 704-878-5305 MOORESVILLE 704-664-5281

IMPROVEMENT PERMIT / AUTHORIZATION TO CONSTRUCT / OPERATION PERMIT / EXISTING SYSTEM INSPECTIO

3:00

PERMIT# 106159/12182 PIN# 4646 20 46 11.24 4646-18-5892

OWNER OR CONTRACTOR DIENST ENTERPRESES / Ryan Homes DATE 10/28/02

ADDRESS PHONE: Business Home

LOCATION Rt WILLIAMSON - TR SUNDOWN ~~CIR~~ TR SUNDOWN COVE - TR 2nd CORONA - ON LT

SUBDIVISION ESTATES @ SUNDOWN BLOCK / SECTION LOT 24 LOT AREA 35681 SITE CLASS. PS DESIGN FLOW 480GPD L.T.A.R. .36 GPD/SF

Septic Tank: 1000 Gallons; STB 312 Date 7-5-04

Pump Tank: 1000 Gallons; PT 27 Date 7-5-04

Pump Make: Model Serial No.

Nitrification Field: No Fields 1 Square Feet 1800 Linear Feet 400

No Lines 3@133 Trench Width 36" Max Trench Bottom Depth 36" Gravel Depth N/A

☑ New System ☐ Repair System Type: I, II, III, IV, V, VI

System Description: PUMP INNOVATIVE

Repair System Description: SAME

Maintenance Agreement Required: ☐ Yes ☑ No

☑ House/Mod. Home No. Bedrooms 4

☐ Mobile Home No. Bathrooms 4

☐ Business No. Employees

☐ Other


☐ Slab ☑ Crawl Space ☑ Basement w/plumbing ☐ Basement wo/plumbing

Water Supply: ☐ Individual ☐ Public ☑ Community


Comments:/Conditions: 1) SEE MAP FOR PUMP RUN EASEMENTS

Comments:/Conditions: Checked tanks & lines 8/6/04 Pressure, elect & alarm 8/31/04

INITIAL SITE SKETCH

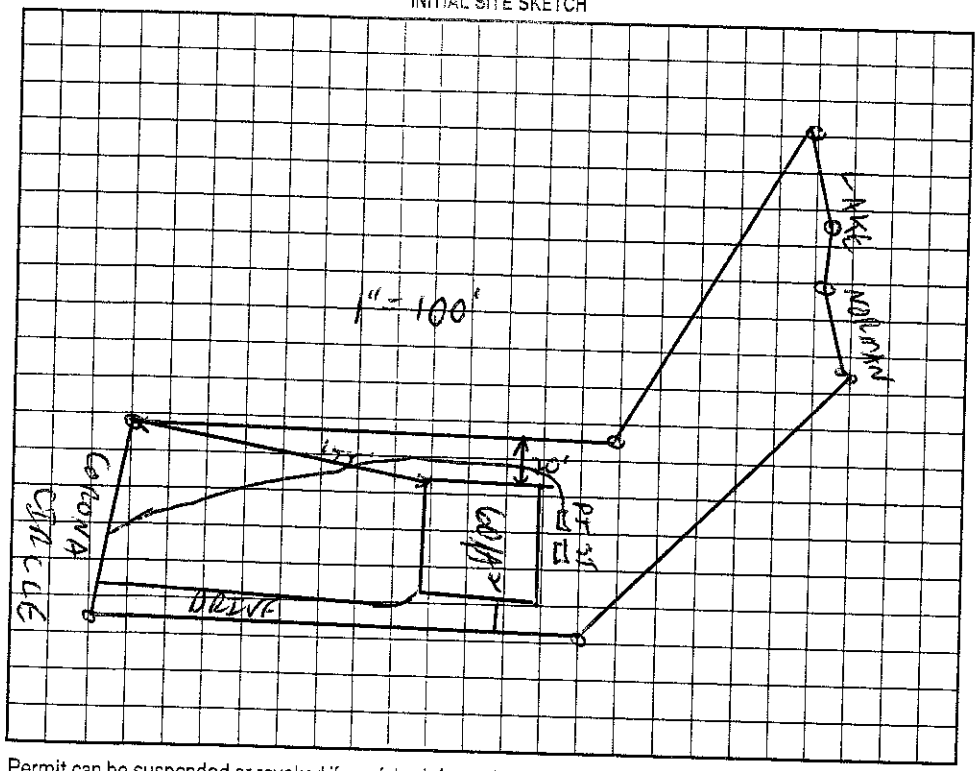

AS BUILT SKETCH

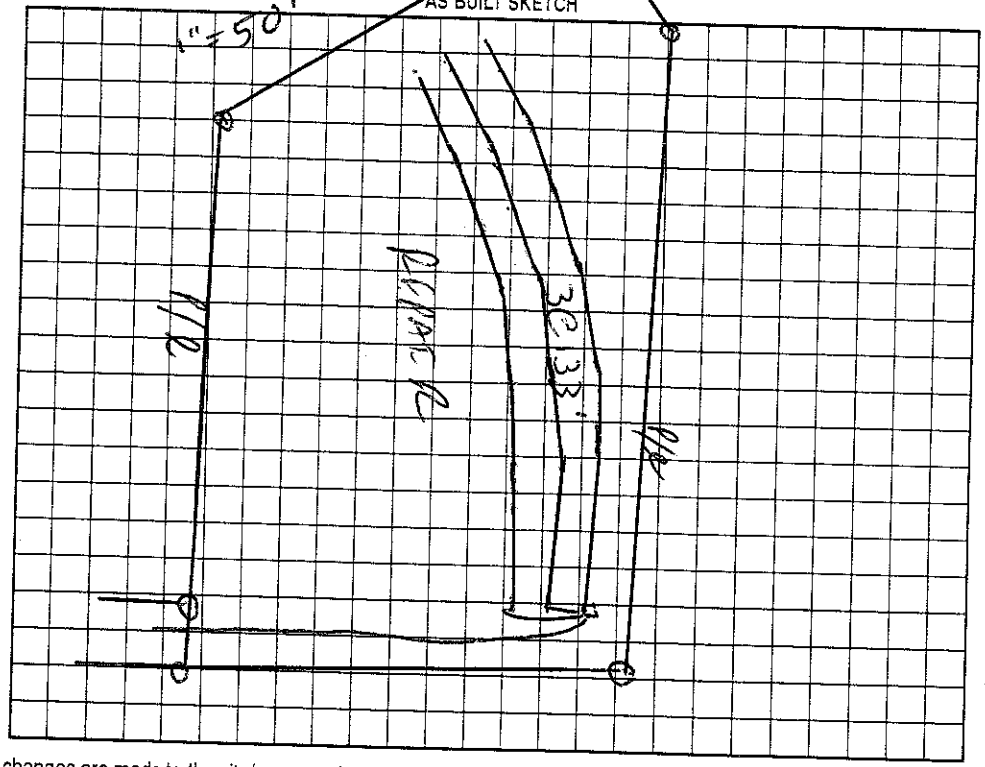

Permit can be suspended or revoked if any false information is supplied toward securing the permit/any unauthorized changes are made to the site/any unauthorized changes are made in the installation of the system. Improvement Permit with plat valid without expiration. Improvement Permit with site plan valid for sixty months. Authorization to Construct is valid for a period equal to that of Improvement Permit – not to exceed sixty months.

Signed: Robert B. Frost date 11/27/02

Improvement Permit by: RS date 10/28/02

Authorization to Construct by: RS date 6/3/04

Installed by: R&H RS

Operation Permit by: date 8/31/04

Existing System Inspection by: date

HEALTH DEPT. COPY: WHITE OWNER COPY (FINAL): YELLOW OWNER COPY (INITIAL): PINK