IREDELL COUNTY HEALTH DEPARTMENT

STATESVILLE 704-878-5305 MOORESVILLE 704-664-5281

IMPROVEMENT PERMIT / AUTHORIZATION TO CONSTRUCT / OPERATION PERMIT / EXISTING SYSTEM INSPECTIO.

PERMIT# 106180 PIN# ~~4646204641116~~ 4046187021 DATE 8/15/02

OWNER OR CONTRACTOR DIENST ENTERPRISES / Ryan Enterprises PHONE: Business 309-0123 Home

ADDRESS 19315 W. CATAWBA AVE. SUITE 200 CORNELIUS NC 28031

LOCATION WILLIAMSON - TR SUNDOWN - TR SUNDOWN COVE - TL CORONA - ON LT

SUBDIVISION ESTATES @ SUNDOWN BLOCK / SECTION LOT 16 LOT AREA 28571 SITE CLASS PS DESIGN FLOW 480GPD L.T.A.R. .36GPD/FT2

Septic Tank: 1000 Gallons: STB 317 Date 11/19/03

Pump Tank: 1000 Gallons: PT 27 Date 2/4/03

Pump Make: MYERS Model ME3F-21 Serial No. 7103

Nitrification Field: No Fields 1 Square Feet 540 Linear Feet 270

No Lines 3 @ 90' Trench Width 24" Max Trench Bottom Depth 36" Gravel Depth N/A

☑ New System ☐ Repair System Type: I, II, III, IV, V, VI

System Description: LP PANEL

Repair System Description: SAME

Maintenance Agreement Required: ☑ Yes ☐ No

☑ House/Mod. Home ☐ Mobile Home ☐ Business ☐ Other

No. Bedrooms 4 No. Bathrooms 4 No. Employees


Water Supply: ☐ Individual ☐ Public ☑ Community

☐ Slab ☑ Crawl Space ☐ Basement w/plumbing ☐ Basement wo/plumbing

Comments/Conditions: 1) INLINE PUMP FILTER TO BE INSTALLED

Comments/Conditions: Tanks & lines Checked by WS 12/23/04
Pressure, electrical & alarm Checked 1-20-04

INITIAL SITE SKETCH 1"=50'

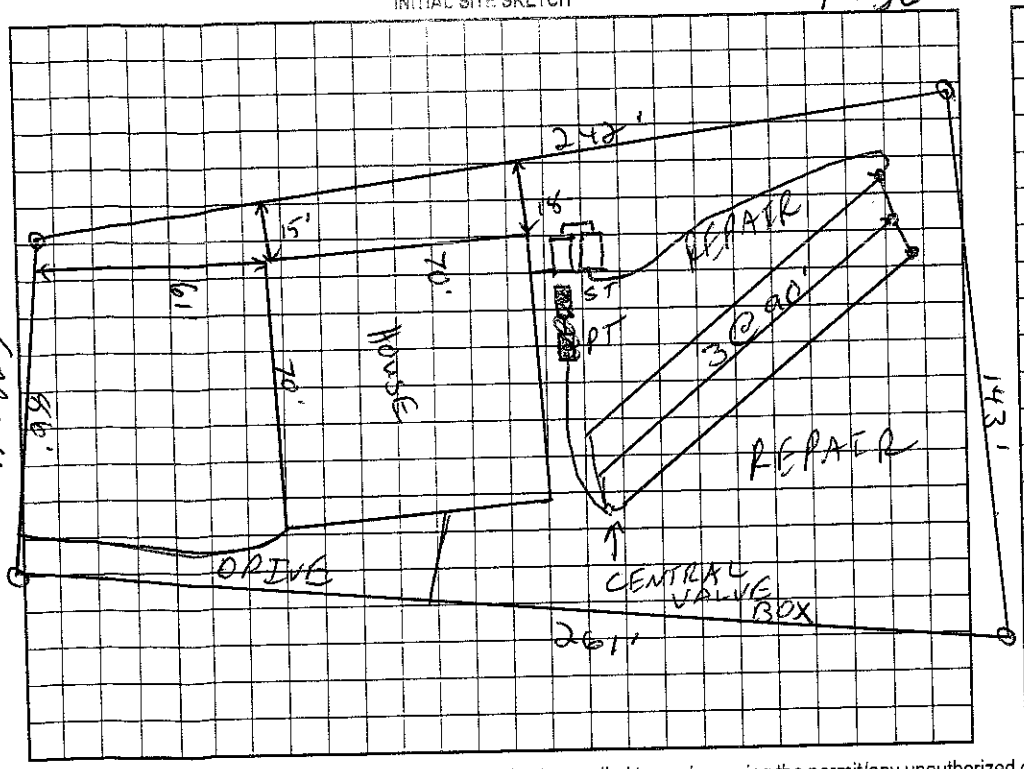

AS BUILT SKETCH

Permit can be suspended or revoked if any false information is supplied toward securing the permit/any unauthorized changes are made to the site/any unauthorized changes are made in the installation of the system. Improvement Permit with plat valid without expiration. Improvement Permit with site plan valid for sixty months. Authorization to Construct is valid for a period equal to that of Improvement Permit – not to exceed sixty months.

Signed: Robert B. Dienst date 9/29/02

Improvement Permit by: RS date 8/15/02

Authorization to Construct by: RS date 9/12/03

Installed by: R+H Elec. RS date 1/22/04

Operation Permit by: date

Existing System Inspection by: date

HEALTH DEPT. COPY: WHITE OWNER COPY (FINAL): YELLOW OWNER COPY (INITIAL): PINK