#245 2100

IREDELL COUNTY HEALTH DEPARTMENT

STATESVILLE 704-878-5305 MOORESVILLE 704-664-5281

IMPROVEMENT PERMIT / AUTHORIZATION TO CONSTRUCT / OPERATION PERMIT / EXISTING SYSTEM INSPECTION

PERMIT# 106 104 PIN# ~~4646-20-4611.88~~ 4646-18-8345 DATE 7/2/03

OWNER OR CONTRACTOR Ryan Homes PHONE: Business 704-875-9887 Home

ADDRESS 9920 Kinsey Ave. Suite 110 Huntersville NC 28078

LOCATION Williamson TR Sundown ~~Cove~~ TR Sundown Cove at end on Lt corner

SUBDIVISION Est. @ Sundown BLOCK / SECTION 2 LOT 88 LOT AREA 25,160 Ft² SITE CLASS. PS DESIGN FLOW 600 L.T.A.R. 0.25

Septic Tank: 1500 Gallons; STB 338 Date 8-30-03
Pump Tank: 1500 Gallons; PT 338 Date 8-30-03
Pump Make: Myers Model ME 50 Serial No.
Nitrification Field: No Fields 1 Square Feet 1200 Linear Feet 400
No Lines 4@ 100' Trench Width 24" or 36" Max Trench Bottom Depth 36" Gravel Depth —

☒ New System ☐ Repair System Type: I, II, III, IV, V, VI
System Description: LP Panel Block
Repair System Description: Same
Maintenance Agreement Required: ☒ Yes ☐ No

☒ House/Mod. Home No. Bedrooms 5
☐ Mobile Home No. Bathrooms 5
☐ Business No. Employees
☐ Other


☐ Slab ☒ Crawl Space ☐ Basement w/plumbing ☐ Basement wo/plumbing

Water Supply:
☐ Individual
☐ Public
☒ Community

Comments:/Conditions: 9Foc 9Foc

1"=50'

INITIAL SITE SKETCH

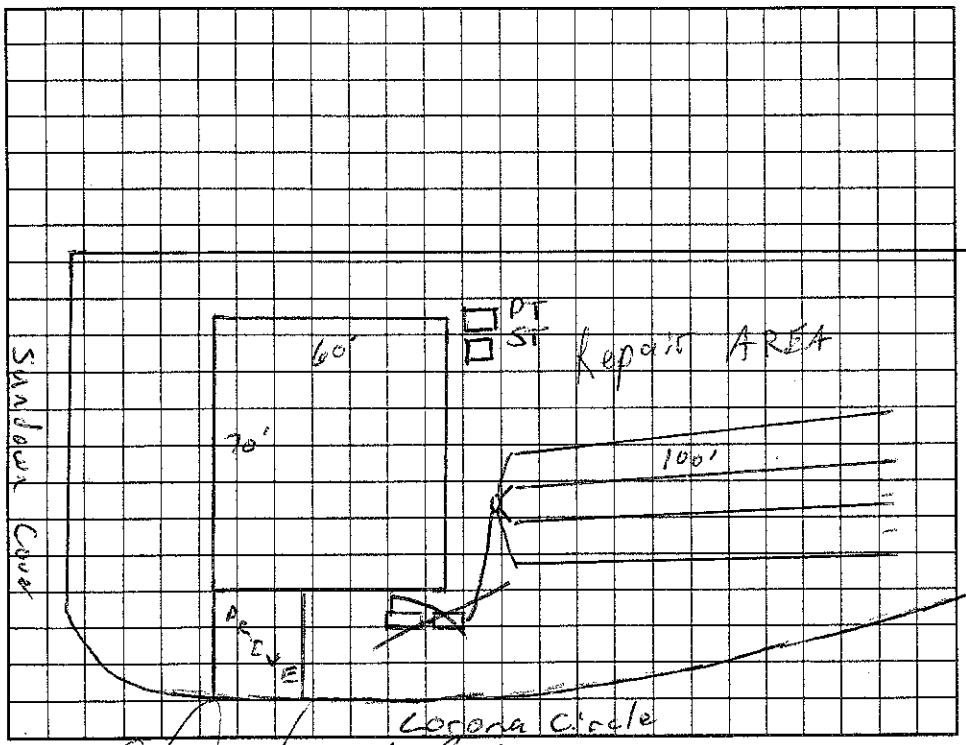

Comments:/Conditions: 3/16" hole drilled
Checked tanks & 2 upper lines
22 panels per line
Checked lower 2 lines 10/6/03

AS BUILT SKETCH

Checked pressure, elect & alarm 10/28/03
Installed as Drawn

Permit can be suspended or revoked if any false information is supplied toward securing the permit/any unauthorized changes are made to the site/any unauthorized changes are made in the installation of the system. Improvement Permit with plat valid without expiration. Improvement Permit with site plan valid for sixty months. Authorization to Construct is valid for a period equal to that of Improvement Permit – not to exceed sixty months.

Signed: date 7/3/03

Improvement Permit by: RS date 7/2/03

Authorization to Construct by: RS date 7/3/03

Installed by: R&H Inc

Operation Permit by: Marvin H. Dotson RS date 10/28/03

Existing System Inspection by: date

HEALTH DEPT. COPY: WHITE OWNER COPY (FINAL): YELLOW OWNER COPY (INITIAL): PINK