IREDELL COUNTY HEALTH DEPARTMENT

STATESVILLE 704-878-5305 MOORESVILLE 704-664-5281

IMPROVEMENT PERMIT / AUTHORIZATION TO CONSTRUCT / OPERATION PERMIT / EXISTING SYSTEM INSPECTION

PERMIT# 106 117 PIN# ~~4646 20 4611 69~~ 4646-18-8656 DATE 11/19/03

OWNER OR CONTRACTOR Ryan Homes PHONE: Business 704-895-9298 Home

ADDRESS 9920 Kincey Ave Huntersville NC 28078 #154

LOCATION Williamson / TR Sundown, TR Sundown Cove on Rt at End

SUBDIVISION Est @ Sunbrook BLOCK / SECTION 2 LOT 69 LOT AREA 25160 ft² SITE CLASS PS DESIGN FLOW ~~460~~ L.T.A.R. 0.3

Septic Tank: 1000 Gallons; STB 794 Date 7-26-04
Pump Tank: 1000 Gallons; PT 27 Date 9-18-04
Pump Make: Sos40786 Model WE03/2M Serial No.
Nitrification Field: No Fields 1 Square Feet 810 Linear Feet 270'
No Lines 3@90' Trench Width 24" or 36" Max Trench Bottom Depth 36" Gravel Depth —

☒ New System ☐ Repair System Type: I, II, III, IV, V, VI
System Description: LP Panel Block
Repair System Description: same
Maintenance Agreement Required: ☒ Yes ☐ No

☒ House/Mod. Home ☐ Mobile Home ☐ Business ☐ Other
No. Bedrooms 4 No. Bathrooms 4 No. Employees
☐ Slab ☒ Crawl Space ☐ Basement w/plumbing ☐ Basement wo/plumbing


Water Supply: ☐ Individual ☐ Public ☒ Community

Comments:/Conditions: 8FOC 9FOC

1"=50'

Comments:/Conditions: Reviewed building & site plans 8/11/04, essentially in compliance with IP (House slightly longer) Faces Sundown Cove

INITIAL SITE SKETCH

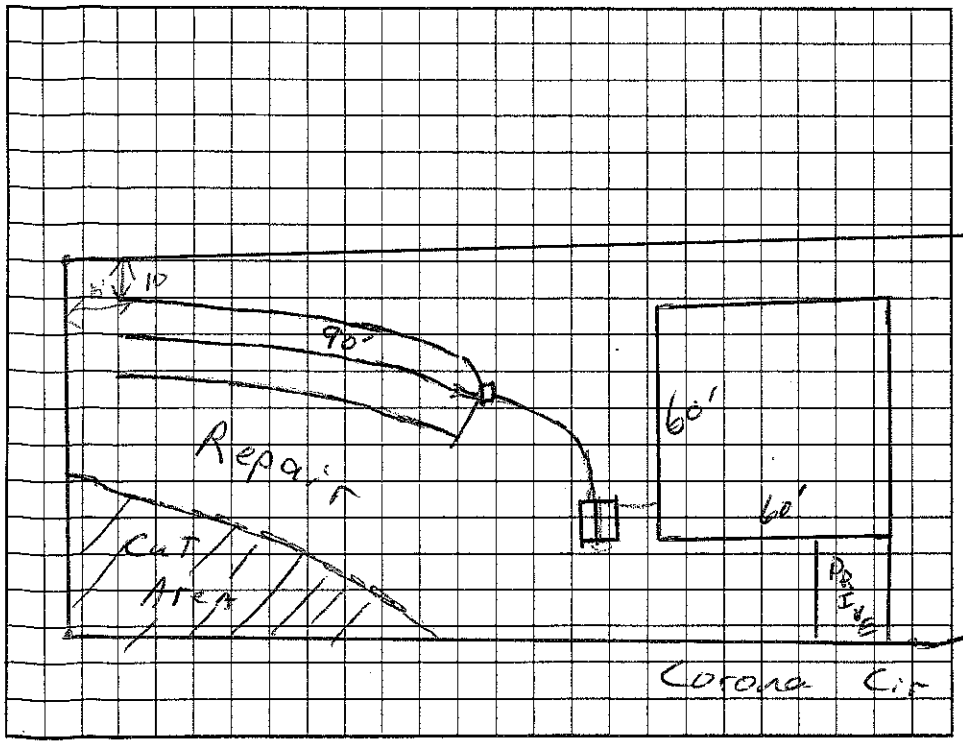

AS BUILT SKETCH

Checked tanks & lines 10/22/04
Pressure, electrical & alarm 12/16/04

Permit can be suspended or revoked if any false information is supplied toward securing the permit/any unauthorized changes are made to the site/any unauthorized changes are made in the installation of the system. Improvement Permit with plat valid without expiration. Improvement Permit with site plan valid for sixty months. Authorization to Construct is valid for a period equal to that of Improvement Permit – not to exceed sixty months.

Signed: Tony Love date 12-10-03 Installed by: R&H RS

Improvement Permit by: RS date 11/19/03 Operation Permit by: Maria H. Dotson date 12/16/04

Authorization to Construct by: Maria H. Dotson RS date 8/11/04 Existing System Inspection by: date

HEALTH DEPT. COPY: WHITE OWNER COPY (FINAL): YELLOW OWNER COPY (INITIAL): PINK