IREDELL COUNTY HEALTH DEPARTMENT

STATESVILLE 704-878-5305 125.00 Paid MOORESVILLE 704-664-5281

3

IMPROVEMENT PERMIT / AUTHORIZATION TO CONSTRUCT / OPERATION PERMIT / EXISTING SYSTEM INSPECTION

PERMIT# 101086 PIN# 4646 19 5469 DATE 7/9/01

OWNER OR CONTRACTOR GTSI / Jeffrey Martin PHONE: Business 704-987-8378 Home

ADDRESS PO Box 2246 Huntersville, NC 28070 FARMSTEAD

LOCATION Brawley sch, TL Farmstead on Rt / Easement - Brawley sch, TL Canvasback, TL Regency, TL Inverness ext end

SUBDIVISION Farmstead BLOCK / SECTION LOT 48+49 LOT AREA SITE CLASS. PS DESIGN FLOW 480 L.T.A.R. 0.3

Septic Tank: 1000 Gallons; STB 1 & 0 Date 8/1/02
Pump Tank: 1000 Gallons; PT 1 & 319 Date 9/17/02
Pump Make: Little Giant Model 1 HP Serial No.
Nitrification Field: No Fields 1 Square Feet 1200 Linear Feet 400
No Lines 6 @ 67' Trench Width 36" Max Trench Bottom Depth 36" Gravel Depth —

☐ New System ☐ Repair System Type: I, II, III, IV, V, VI
System Description: Pump 25% Reduction
Repair System Description: LPPBS
Maintenance Agreement Required: ☐ Yes ☒ No

☒ House/Mod. Home No. Bedrooms 4
☐ Mobile Home No. Bathrooms 4
☐ Business No. Employees
☐ Other
☐ Slab ☐ Crawl Space ☒ Basement w/plumbing ☐ Basement wo/plumbing


Water Supply: ☒ Individual ☐ Public ☐ Community

Comments:/Conditions: Install lines on contour - Keep well 100' from Tanks


Comments:/Conditions:

Ind. Hookups Installed

INITIAL SITE SKETCH

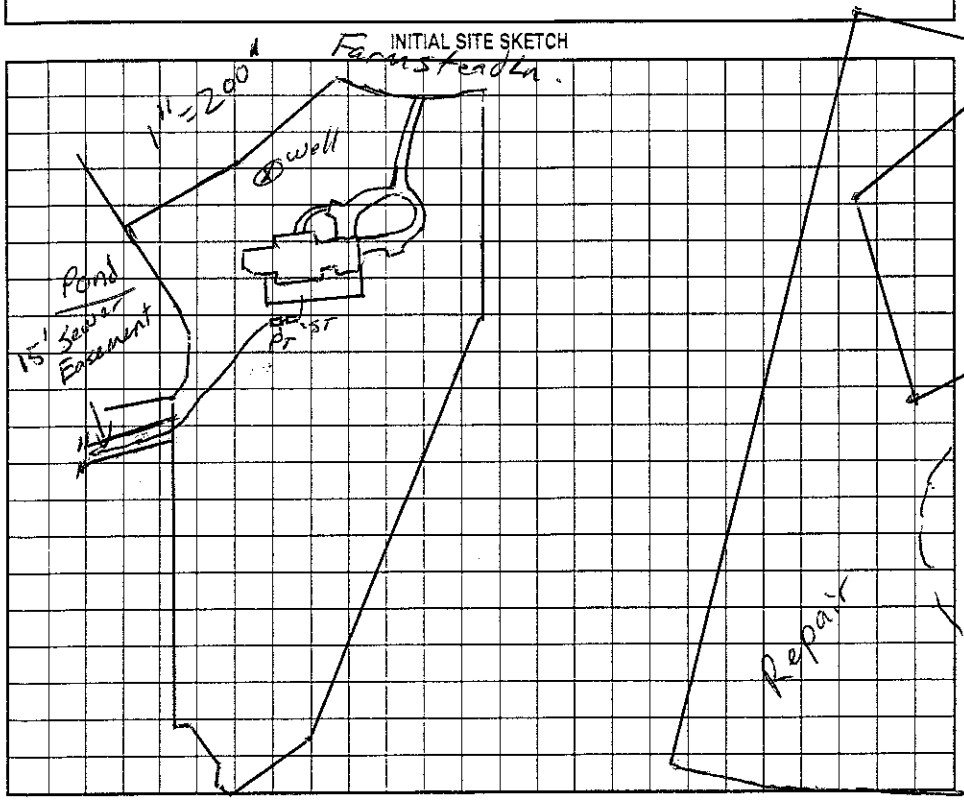

AS BUILT SKETCH

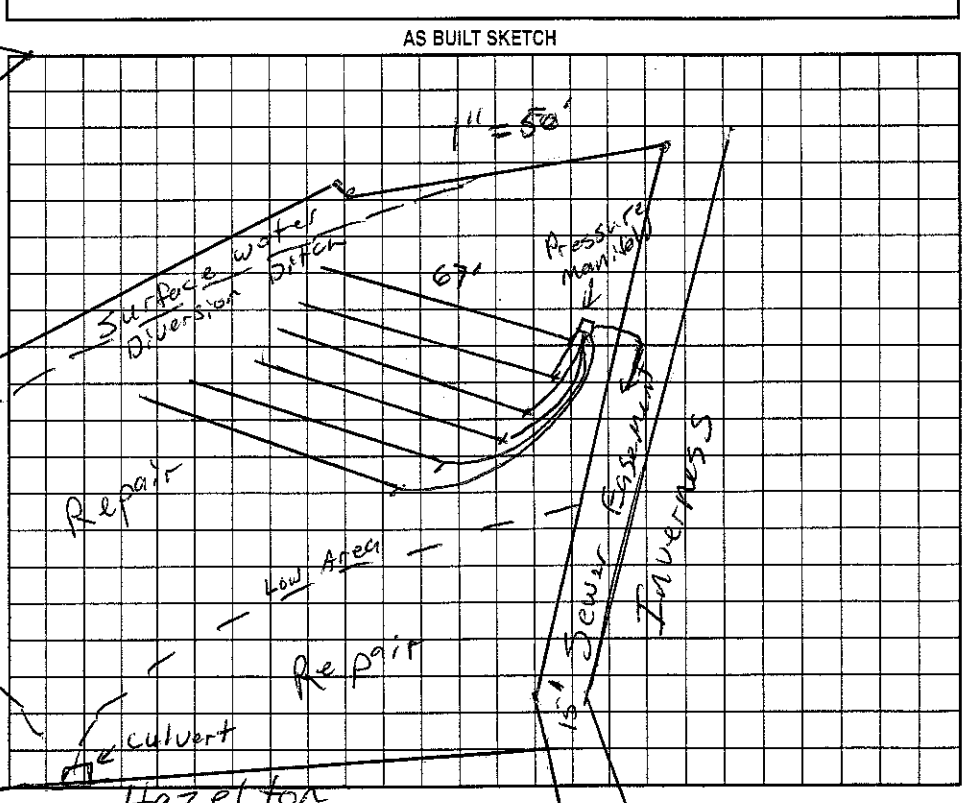

Permit can be suspended or revoked if any false information is supplied toward securing the permit/any unauthorized changes are made to the site/any unauthorized changes are made in the installation of the system. Improvement Permit with plat valid without expiration. Improvement Permit with site plan valid for sixty months. Authorization to Construct is valid for a period equal to that of Improvement Permit - not to exceed sixty months.

Signed: Jeffrey C. Underwood (for Jeffrey Martin) date 7/11/01

Improvement Permit by: RSE date 7/9/01

Authorization to Construct by: RSE date 7/9/01

Installed by: McLeod

Operation Permit by: Wesley Sparks R.S. date 1/3/03

Existing System Inspection by: date

HEALTH DEPT. COPY: WHITE OWNER COPY (FINAL): YELLOW OWNER COPY (INITIAL): PINK