IREDELL COUNTY HEALTH DEPARTMENT

STATESVILLE 704-878-5305 MOORESVILLE 704-664-5281

IMPROVEMENT PERMIT / AUTHORIZATION TO CONSTRUCT / OPERATION PERMIT / EXISTING SYSTEM INSPECTI

PERMIT# 108466 PIN# 4696 28461l. 97 4646-19-8145 DATE 11/1/02

OWNER OR CONTRACTOR SUNDOWN COVE LLC PHONE: Business 309-0123 Home

ADDRESS 165 BROADBELL DR. MOORESVILLE NC 28117

LOCATION WILLIAMSON-TR SUNDOWN-TR SUNDOWN COVE-TR CORONA-ON RT

SUBDIVISION ESTATES @ SUNDOWN BLOCK / SECTION LOT 97 LOT AREA 5.27AC SITE CLASS. PS DESIGN FLOW 800GPD L.T.A.R. .25000/FT2

Septic Tank: 1500 Gallons; STB 338 Date 3-26-04
Pump Tank: 1500 Gallons; PT 421 Date 4-26-04
Pump Make: Myers Model ME 50 Serial No.
Nitrification Field: No Fields 1 Square Feet 2400 Linear Feet 800
No Lines 5@160' Trench Width 36" Max Trench Bottom Depth 36" Gravel Depth N/A

☑ New System ☐ Repair System Type: I, II, (III) IV, V, VI
System Description: PUMP INNOVATIVE
Repair System Description: SAME
Maintenance Agreement Required: ☐ Yes ☑ No

☐ House/Mod. Home No. Bedrooms
☐ Mobile Home No. Bathrooms
☐ Business No. Employees
☑ Other POOL 80 persons @ 10 gpp


☐ Slab ☑ Crawl Space ☐ Basement w/plumbing ☐ Basement wo/plumbing

Water Supply:
☐ Individual
☐ Public
☑ Community


Comments:/Conditions: MAY MOVE POOL AREA UP 25'-30' TOWARD WELL LOT - 12/17/02 CBR

Comments:/Conditions: 80 persons @ 10 GAL. PER PERSON
Tanks Checked 5/26/04, lines Checked
Pressure, elect. & alarm 6/23/04 MD
Notes, Concrete curb crossed ST.

INITIAL SITE SKETCH

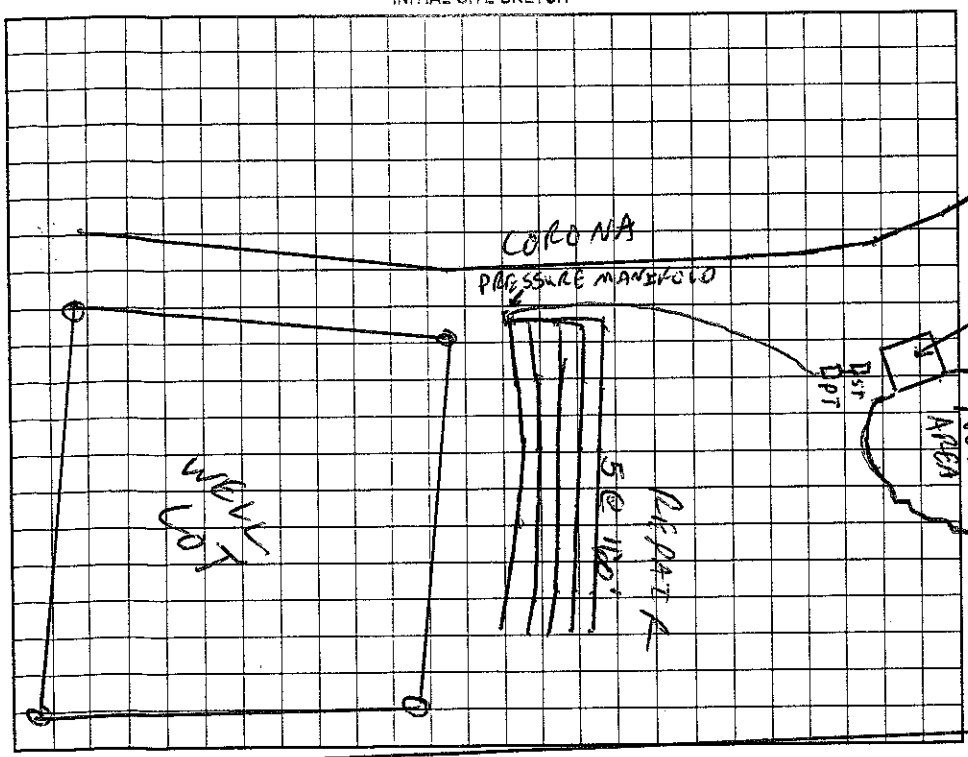

AS BUILT SKETCH

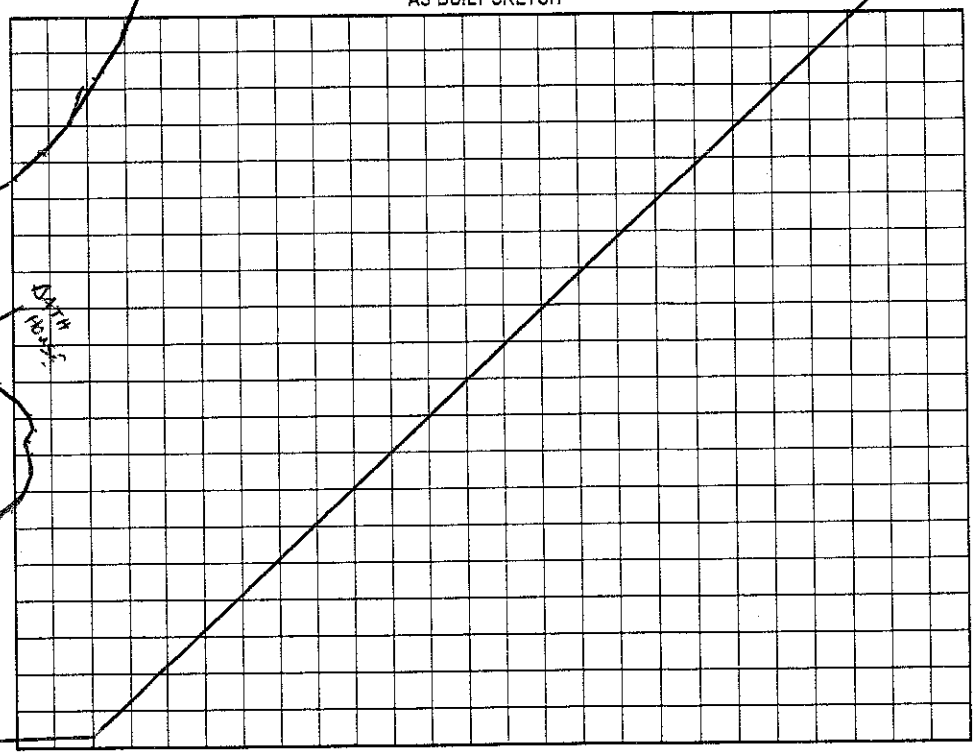

Permit can be suspended or revoked if any false information is supplied toward securing the permit/any unauthorized changes are made to the site/any unauthorized changes are made in the installation of the system. Improvement Permit with plat valid without expiration. Improvement Permit with site plan valid for sixty months. Authorization to Construct is valid for a period equal to that of Improvement Permit – not to exceed sixty months.

Signed: Robert B. Hiatt date 11/27/02 Installed by: R&H Inc

Improvement Permit by: CBR RS date 11/1/02 Operation Permit by: Maria H Johnson RS date 6/23/04

Authorization to Construct by: CBR RS date 11/1/02 Existing System Inspection by: date

HEALTH DEPT. COPY: WHITE OWNER COPY (FINAL): YELLOW OWNER COPY (INITIAL): PINK