IREDELL COUNTY HEALTH DEPARTMENT

STATESVILLE 704-878-5305 MOORESVILLE 704-664-5281

IMPROVEMENT PERMIT / CERTIFICATE OF COMPLETION / OPERATION PERMIT / EXISTING SYSTEM INSPECTION

PROPERTY DESCRIPTION NO. 22739 DATE Jan 10, '96 TAX MAP NO. 2K-22A 23/24 4646 19 8969 Watershed: ☑ Yes ☐ No

OWNER OR CONTRACTOR Donald R. Oslinger PHONE: Business Home 588-6122 WS4CA

ADDRESS 4847 Trojan Dr. Charlotte

LOCATION Brawley Sch Rd. TL Farmstead Ln. TL Pondridge Ln. immediately on Right

SUBDIVISION Farmstead BLOCK / SECTION II LOT 59 & 60 combined LOT AREA ~ 1Ac SITE CLASS. PS DESIGN FLOW 360gpd L.T.A.R. ~.25

Septic Tank: 1000 Gallons; STB 1012 Date 5/20/96

Pump Tank: 1000 Gallons; PT 17 Date 11/12/95

Pump Make: Model Serial No.

Nitrification Field: No Fields 1 Square Feet 1500 Linear Feet 500

No Lines 5 Trench Width 36" Max Trench Bottom Depth 24" Gravel Depth 12"

☑ New System ☐ Repair System Type: I, II, (III), IV, V, VI

System Description: pumped-pm-conventional

Repair System Description: Shallow pumped conv.

Maintenance Agreement Required: ☐ Yes ☑ No

☑ House/Mod. Home No. Bedrooms 3

☐ Mobile Home No. Bathrooms 2½

☐ Business No. Employees

☐ Other

☐ Slab ☐ Crawl Space ☑ Basement w/plumbing ☐ Basement wo/plumbing


Water Supply: ☑ Individual ☐ Community ☐ Public

Comments: Keep Laterals shallow

Comments: PARTIAL
Lines, Tanks Checked on 6/26/96

1" = 100'

INITIAL SITE SKETCH

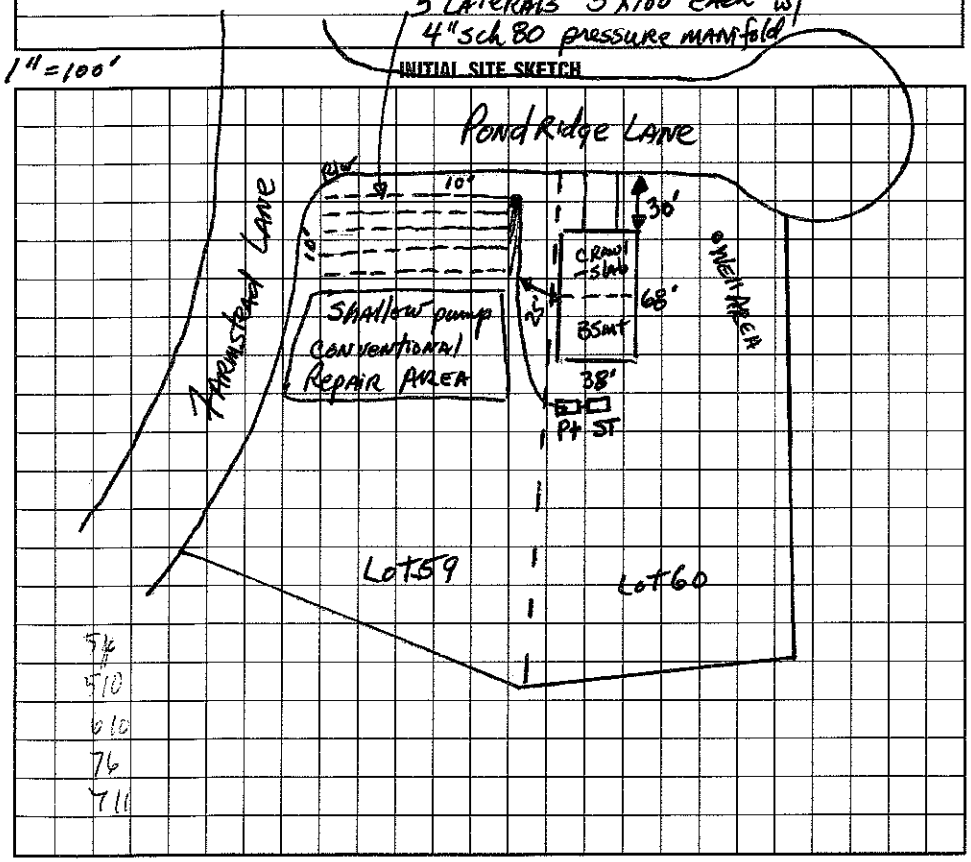

AS BUILT SKETCH

SAME AS INITIAL SITE SKETCH

I understand that this permit can be suspended or revoked if any false information is supplied toward securing the permit/any unauthorized changes are made to the site/any unauthorized changes are made in the installation of the system.

Signed: Donald R. Oslinger

Improvement Permit by: Jack R. Hinson, RS date 1-10-96

Existing System Inspection by: Jack R. Hinson, RS date 1-10-96

Installed by: RICHARD ABERNATHY

Certificate of Completion by: date

Operation Permit by: C. Blackstock EHS date 9/19/96

to construct

DEPT. COPY: WHITE INSPECTION COPY (FINAL): GREEN OWNER COPY (FINAL): YELLOW INSPECTION COPY (INITIAL): PINK OWNER COPY (INITIAL): GOLD