PN# 4646-20-9989

1165

IREDELL COUNTY HEALTH DEPARTMENT

STATESVILLE 704-878-5305 MOORESVILLE 704-664-5281

IMPROVEMENT PERMIT / CERTIFICATE OF COMPLETION / OPERATION PERMIT / EXISTING SYSTEM INSPECTION

PROPERTY DESCRIPTION NO. 22404 DATE 12/28/95 TAX MAP NO. 2G 5C 5 Watershed: [X] Yes [ ] No

OWNER OR CONTRACTOR Scott Poltorak PHONE: Business Home 216-835-5951

ADDRESS 25627 Eaton Way Bay Village, OH. 44140

LOCATION Williamson Rd TR Alcove TR Catalina on (L) across from "Cottage Place"

SUBDIVISION Catalina Cove BLOCK / SECTION LOT 5 LOT AREA .6 AC SITE CLASS. PS DESIGN FLOW 360 L.T.A.R. .25

Septic Tank: 1000 Gallons; STB 794 Date 2/26/97

Pump Tank: Gallons; PT Date

Pump Make: Model Serial No.

Nitrification Field: No Fields 1 Square Feet 1440 Linear Feet *240 (480)

No Lines 3 Trench Width 24" Max Trench Bottom Depth 32" Gravel Depth SAND

[X] New System [ ] Repair System Type: I, II, (III), IV, V, VI

System Description: Gravity Prefab Panel

Repair System Description: Pressure Panel

Maintenance Agreement Required: [X] Yes [ ] No 5 YR.

[X] House/Mod. Home No. Bedrooms 3

[ ] Mobile Home No. Bathrooms 3

[ ] Business No. Employees

[ ] Other


[ ] Slab [X] Crawl Space [ ] Basement w/plumbing [ ] Basement wo/plumbing

Water Supply: [X] Individual [ ] Community [ ] Public


Comments: Very tight - House only 45' from road R/W in order to get proposed Panel on lot.

Comments: Installed as shown on Auth TR Const.

INITIAL SITE SKETCH

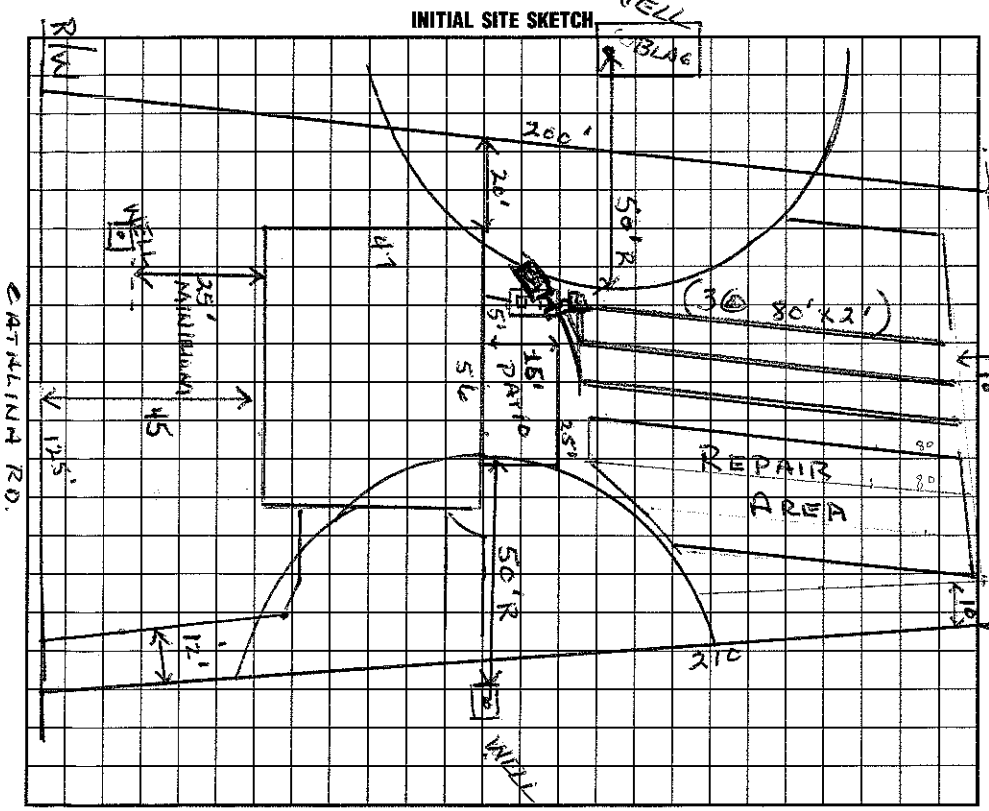

AS BUILT SKETCH

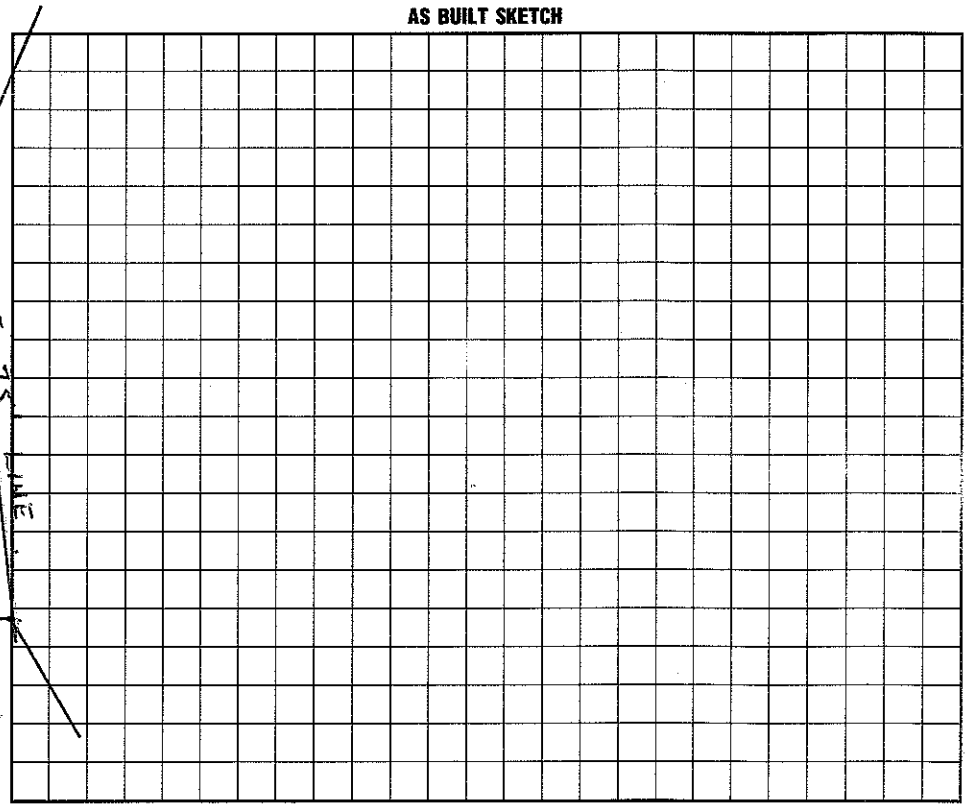

I understand that this permit can be suspended or revoked if any false information is supplied toward securing the permit/any unauthorized changes are made to the site/any unauthorized changes are made in the installation of the system.

Signed: Scott A. Poltorak

Improvement Permit by: Wesley Sparks RS date 12/28/95

Existing System Inspection by: Wesley Sparks RS date 12/2/96

Installed by: Larry Beam

Certificate of Completion by: Wesley Sparks R.S. date 5/14/97

Operation Permit by: Wesley Sparks RS date 5/14/97

HEALTH DEPT. COPY: WHITE INSPECTION COPY (FINAL): GREEN OWNER COPY (FINAL): YELLOW INSPECTION COPY (INITIAL): PINK OWNER COPY (INITIAL): GOLD