$250 11:30

IREDELL COUNTY HEALTH DEPARTMENT

STATESVILLE 704-878-5305 MOORESVILLE 704-664-5281

IMPROVEMENT PERMIT / AUTHORIZATION TO CONSTRUCT / OPERATION PERMIT / EXISTING SYSTEM INSPECTION

PERMIT# 140012 PIN# 4646216854 DATE 1-9-07

OWNER OR APPLICANT Sam N Hammer Inc PHONE: Business 980-721-3282 Home

ADDRESS 186 Marietta Rd Mooresville

LOCATION Williamson Rd TR Alcove TR Catalina on right 2nd driveway after Malibu Rd 296 Catalina

SUBDIVISION BLOCK / SECTION LOT LOT AREA 1.516 SITE CLASS PS DESIGN FLOW 240gpd L.T.A.R. .3gpd/ft²

Septic Tank: 1000 Gallons; STB 312 Date 3-25-07
Pump Tank: Gallons; PT Date
Pump Make: Model Serial No.
Nitrification Field: No Fields 1 Square Feet Linear Feet 200
No Lines 3 @ 68' Trench Width 36" Max Trench Bottom Depth 36"

☐ New System ☐ Repair ☒ Expansion System Type: I II III IV V VI
System Description: 25% reduction gravity
Repair System Description: 25% reduction pump
Maintenance Agreement Required: ☐ Yes ☒ No

☒ House/Mod. Home No. Bedrooms 5
☐ Mobile Home No. Persons
☐ Business No. Employees
☐ Other

Water Supply: ☒ Individual ☐ Public ☐ Community


Gravel Depth NA ☒ Gravity ☐ Pressure ☐ Slab ☒ Crawl Space ☐ Basement w/plumbing ☐ Basement wo/plumbing

Comments:/Conditions: *Expansion from 3 bd. to 5 bd.
Split plumbing between 2 systems with Kitchen on one and laundry on other
D-Box or end cap distribution

Comments:/Conditions:
Some grading required to keep trenches ON contour - Cut only - Do not fill
Line 1 = 64 2 = 68 3 = 72

INITIAL SITE SKETCH

1" = 60'

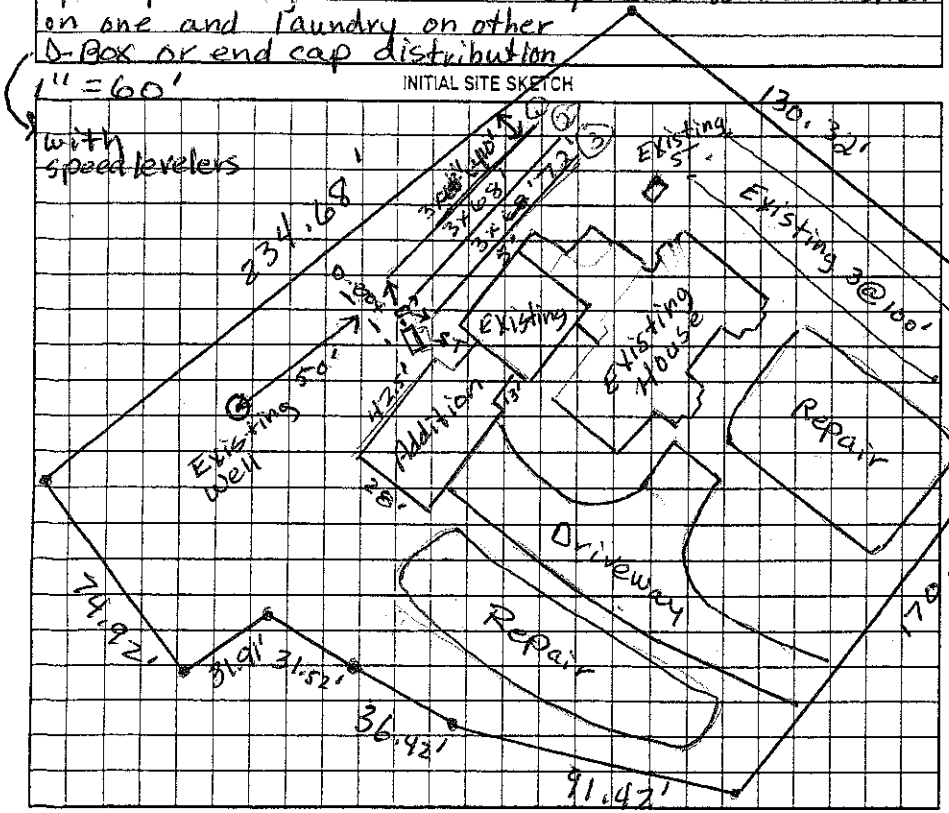

AS BUILT SKETCH

Installed Quick 4 Plastic Chambers essentially as Drawn

Permit can be suspended or revoked if any false information is supplied toward securing the permit/any unauthorized changes are made to the site/any unauthorized changes are made in the installation of the system. Improvement Permit with ~~plat~~ valid without expiration ☐ Improvement Permit with site plan valid for sixty months ☒ Authorization to Construct is valid for a period equal to that of Improvement Permit – not to exceed sixty months.

Signed: date 1-20-07 Installed by: R & H RS

Improvement Permit by: Judy Melville date 1-9-07 Operation Permit by: date 5/31/07

Authorization to Construct by: Judy Melville date 1-9-07 Existing System Inspection by: date

HEALTH DEPT. COPY: WHITE OWNER COPY (FINAL): YELLOW OWNER COPY (INITIAL): PINK