IREDELL COUNTY HEALTH DEPARTMENT

STATESVILLE 704-878-5305 MOORESVILLE 704-664-5281

IMPROVEMENT PERMIT / CERTIFICATE OF COMPLETION / OPERATION PERMIT / EXISTING SYSTEM INSPECTION

PROPERTY DESCRIPTION NO. 15560 DATE Sept 3, '93 TAX MAP NO. 2H-1-A-26

OWNER OR CONTRACTOR Joseph Gamewell PHONE: ~~Business~~ PIN# 4646-23-1781 Home

ADDRESS

LOCATION 1109 TR Pondarosa ½ mile on Right

SUBDIVISION Bonanza BLOCK / SECTION LOT 26 LOT AREA 30,000 SF SITE CLASS. PS per 1956 L.T.A.R. ~.35

Water Supply: ☐ Individual ☐ Community ☐ Public

Septic Tank: 1000 Gallons; STB 794 (Dellinger) Date 7-1-93

Pump Tank: Gallons; PT Date

Nitrification Field: No Fields 1 Square Feet 1020 Linear Feet ~340

No Lines 4 Trench Width 36" Trench Depth ~36" Gravel Depth 12"

☑ New System ☐ Repair System Type: I, (II), III, IV, V-VI

System Description: gravity conventional

Repair System Description: LPPPBPS

Maintenance Agreement Required: ☐ Yes ☑ No

☑ House/Mod. Home No. Bedrooms 3 Garbage Disposal: ☐ Yes ☑ No

☐ Mobile Home No. Bathrooms 3 Auto. Dishwasher: ☑ Yes ☐ No

☐ Business No. Employees Auto. Washing Machine: ☑ Yes ☐ No


☐ Other Other

☐ Slab ☐ Crawl Space ☑ Basement w/plumbing ☐ Basement wo/plumbing

Comments Linear footage ~10' less than shown on IP in order to stay at least 10' within boundaries.

INITIAL SITE SKETCH

AS BUILT SKETCH

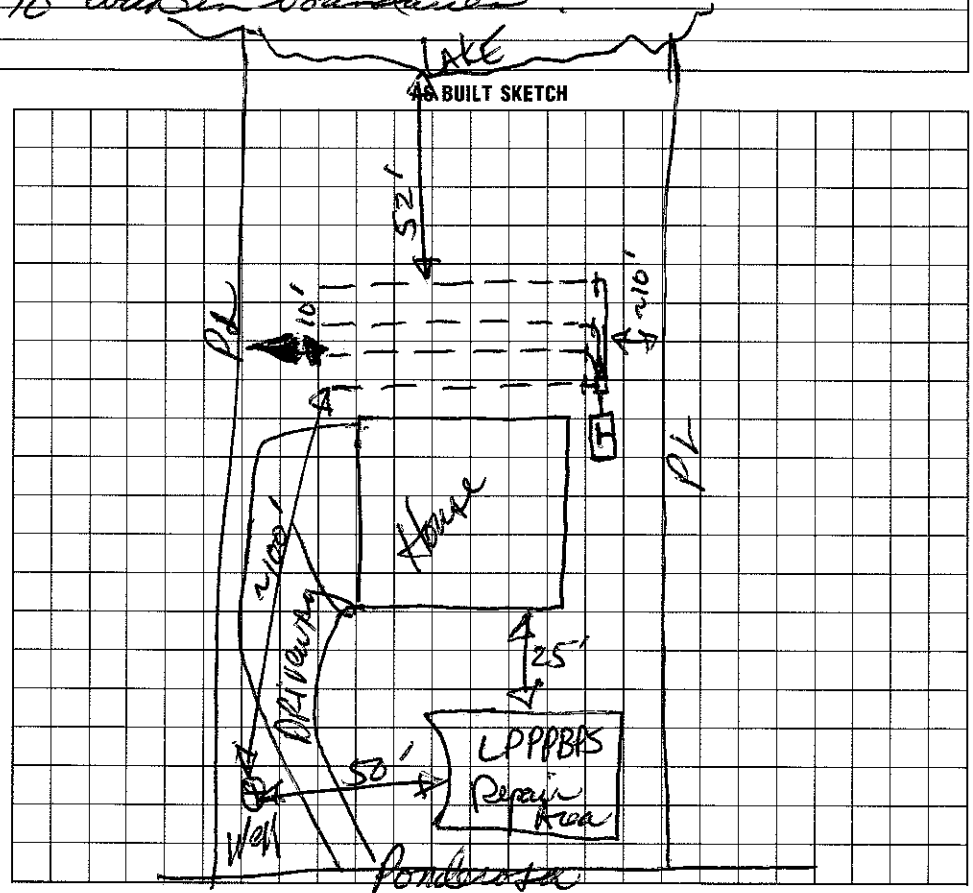

I understand that this permit can be suspended or revoked if any false information is supplied toward securing the permit/any unauthorized changes are made to the site/any unauthorized changes are made in the installation of the system. Improvement Permit is valid for 60 months from date of issuance.

Signed:

Improvement Permit by: date

Existing System Inspection by: date

Installed by:

Certificate of Completion by: , RS date 9/3/93

Operation Permit by: date

HEALTH DEPT. COPY: WHITE INSPECTION COPY (FINAL): GREEN OWNER COPY (FINAL): YELLOW INSPECTION COPY (INITIAL): PINK OWNER COPY (INITIAL): GOLD