4646-23-1973

IREDELL COUNTY HEALTH DEPARTMENT

Statesville Phone TR 3-7271 Mooresville Phone NO 3-1271

PERMIT TO INSTALL SEPTIC TANK

Permit No. 43 Permit Date May 12 1971

Owner MRS Robert LEE Address 2517 Plumb St. Charlotte

Installed By NORMANS INC. Address MOORESVILLE, NC

Location of Property


Bonanza Develop. LOT 34

Tank		Capacity		Length of Lines		Fixtures	
Block	( )	1000	(✓)	225'	(✓)	No. of Baths	(2)
Precast	(✓)	1250	( )	250'	( )	Dishwasher	( )
		1500	( )	Other		Garbage Grdr.	( )
		Other				Other	

NOTIFY HEALTH DEPARTMENT AT LEAST EIGHT HOURS BEFORE TANK IS TO BE INSPECTED.

Final Inspection May 12 1971 Approved (✓) Disapproved ( )

Remarks

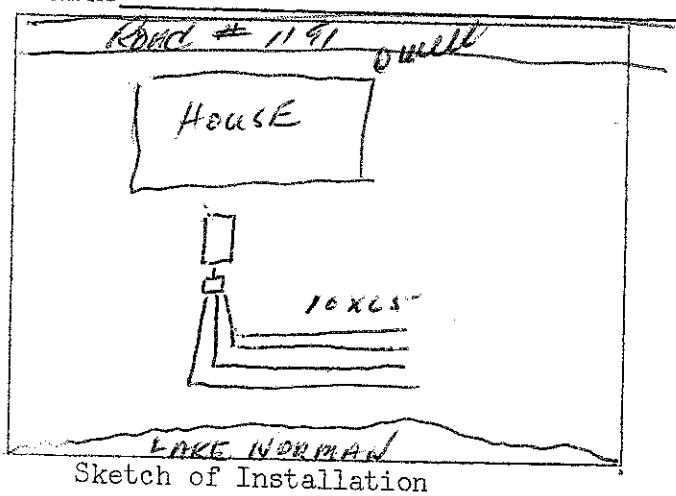

Sketch of Installation

Sanitarian