IREDELL COUNTY HEALTH DEPARTMENT

PIN# 4646-23-4474

STATESVILLE 704-878-5305 MOORESVILLE 704-664-5281

IMPROVEMENT PERMIT / CERTIFICATE OF COMPLETION / OPERATION PERMIT / EXISTING SYSTEM INSPECTION

PROPERTY DESCRIPTION NO. 20096 DATE 1/19/95 TAX MAP NO. 2H-1-A-74, 77 Watershed: ☐ Yes ☐ No

OWNER OR CONTRACTOR Wilford Wade III PHONE: Business Home 664-2373

ADDRESS 343 Ponderosa Cir Mocksville 28115

LOCATION

SUBDIVISION Bonanza BLOCK / SECTION LOT A5=74 LOT AREA ~1Ac SITE CLASS. P DESIGN FLOW L.T.A.R. 1.4

Septic Tank: 1000 Gallons; STB Date

Pump Tank: Gallons; PT Date

Pump Make: Model Serial No.

Nitrification Field: No Fields Square Feet Existing Linear Feet

No Lines Trench Width Max Trench Bottom Depth Gravel Depth

☐ New System ☐ Repair System Type: I, II, III, IV, V, VI

System Description: Existing

Repair System Description:

Maintenance Agreement Required: ☐ Yes ☐ No

☐ House/Mod. Home No. Bedrooms

☐ Mobile Home No. Bathrooms

☐ Business No. Employees

☐ Other

☐ Slab ☐ Crawl Space ☐ Basement w/plumbing ☐ Basement wo/plumbing


Water Supply: ☐ Individual ☐ Community ☐ Public

Comments:

Comments: Adding captain bath

INITIAL SITE SKETCH

AS BUILT SKETCH

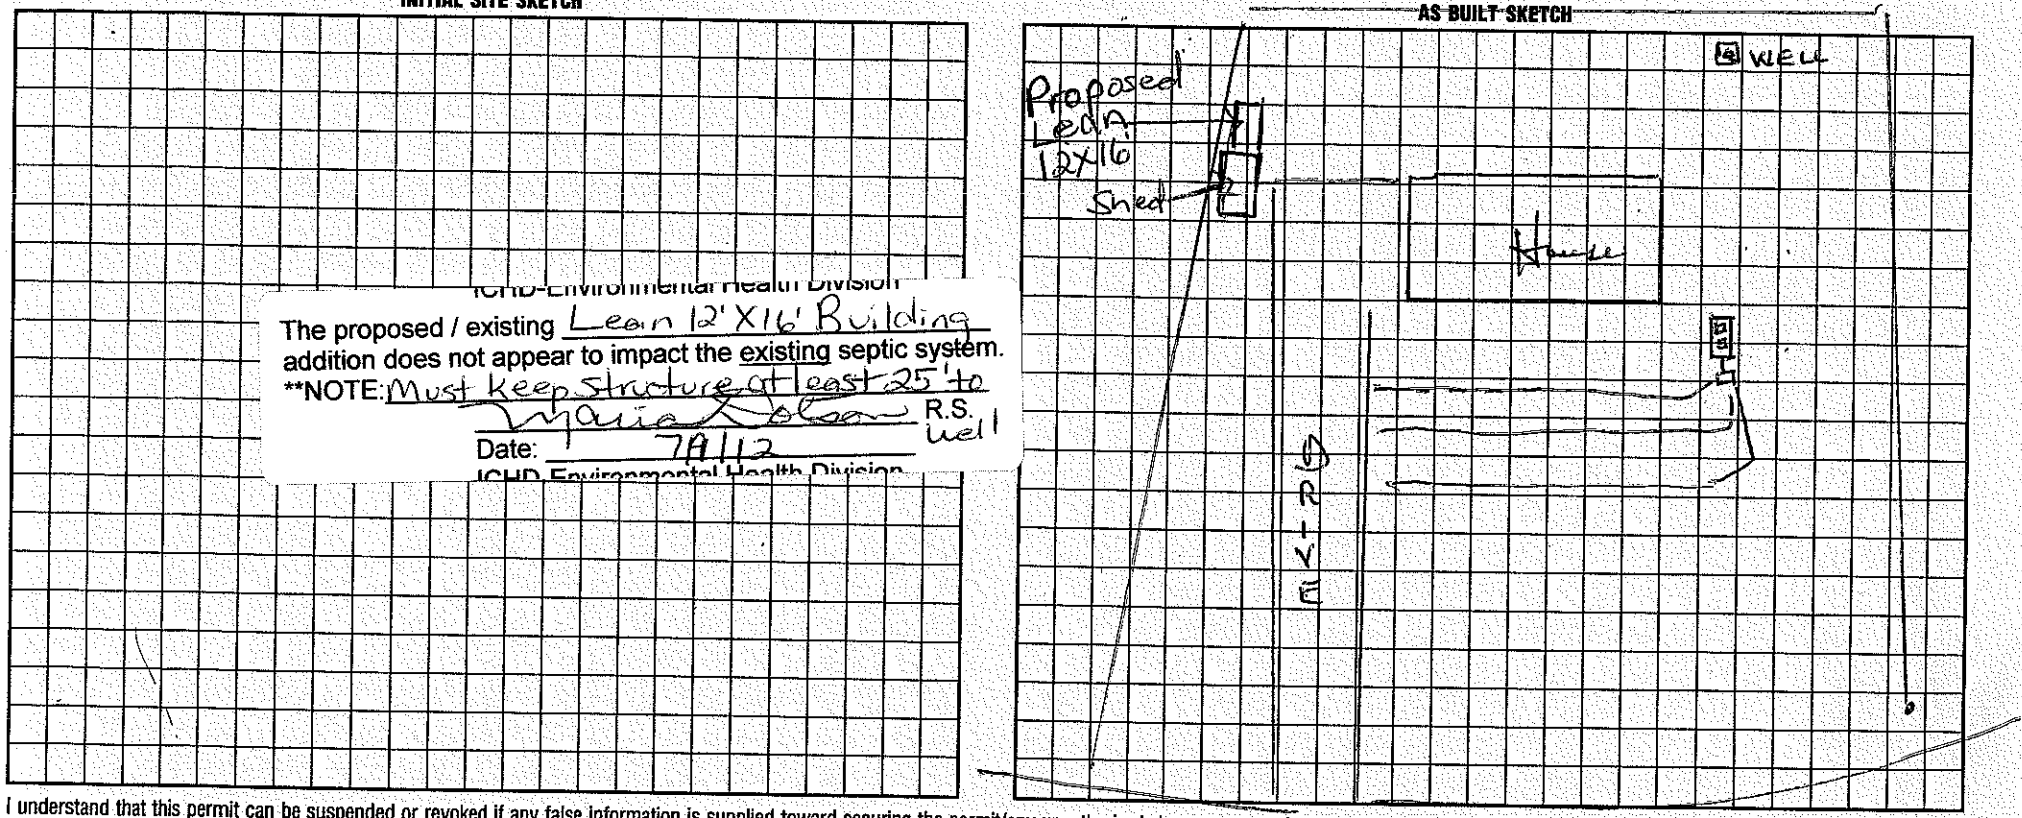

ICHD-Environmental Health Division

The proposed / existing Lean 12'X16' Building addition does not appear to impact the existing septic system.

**NOTE: Must keep Structure at least 25' to well

Maria Kolesar R.S.

Date: 7/1/12

ICHD-Environmental Health Division

I understand that this permit can be suspended or revoked if any false information is supplied toward securing the permit/any unauthorized changes are made to the site/any unauthorized changes are made in the installation of the system. Improvement Permit is valid for 60 months from date of issuance.

Signed:

Improvement Permit by: date

Existing System Inspection by: Wesley Sparks R.S. date 1/19/95

Installed by:

Certificate of Completion by: date

Operation Permit by: date

PONDEROSA CIR.

HEALTH DEPT. COPY: WHITE INSPECTION COPY (FINAL): GREEN OWNER COPY (FINAL): YELLOW INSPECTION COPY (INITIAL): PINK OWNER COPY (INITIAL): GOLD