IREDELL COUNTY HEALTH DEPARTMENT

STATESVILLE 704-878-5305 MOORESVILLE 704-664-5281

IMPROVEMENT PERMIT / CERTIFICATE OF COMPLETION / OPERATION PERMIT / EXISTING SYSTEM INSPECTION

PROPERTY DESCRIPTION NO. 23641 DATE May 7, '96 TAX MAP NO. 2H 1A 33 4646 23 5028 Watershed: ☑ Yes ☐ No

OWNER OR CONTRACTOR William J. Dixon PHONE: Business Home 664-5753

ADDRESS 108 Forum Dr. Mooresville

LOCATION Williamson Rd. Turn on Ponderosa on Right before pavement ends.

SUBDIVISION Bonanza BLOCK / SECTION LOT 33 LOT AREA .57Ac SITE CLASS. PS pre 1978 DESIGN FLOW 360 gpd L.T.A.R. .3

Septic Tank: 1000 Gallons; STB 794 Date 10/22/96

Pump Tank: 1000 Gallons; PT 27 Date 10/1/96

Pump Make: HYDROMATIC Model Serial No. 5K50

Nitrification Field: No Fields 1 Square Feet 900 Linear Feet 300

No Lines 5@60' Trench Width 36" Max Trench Bottom Depth 36" Gravel Depth N/A

☑ New System ☐ Repair System Type: I, II, III, IV, V, VI

System Description: 9M Chambered

Repair System Description: Black Panel

Maintenance Agreement Required: ☐ Yes ☑ No

☑ House/Mod. Home No. Bedrooms 3

☐ Mobile Home No. Bathrooms 2½

☐ Business No. Employees

☐ Other

☐ Slab ☐ Crawl Space ☑ Basement w/plumbing ☐ Basement wo/plumbing


Water Supply: ☑ Individual ☐ Community ☐ Public

Comments: Lot recorded approx 1964 - Installed supply line 5' off property line along side of house


Comments: 300 / 4 / 190

1"=40'

INITIAL SITE SKETCH

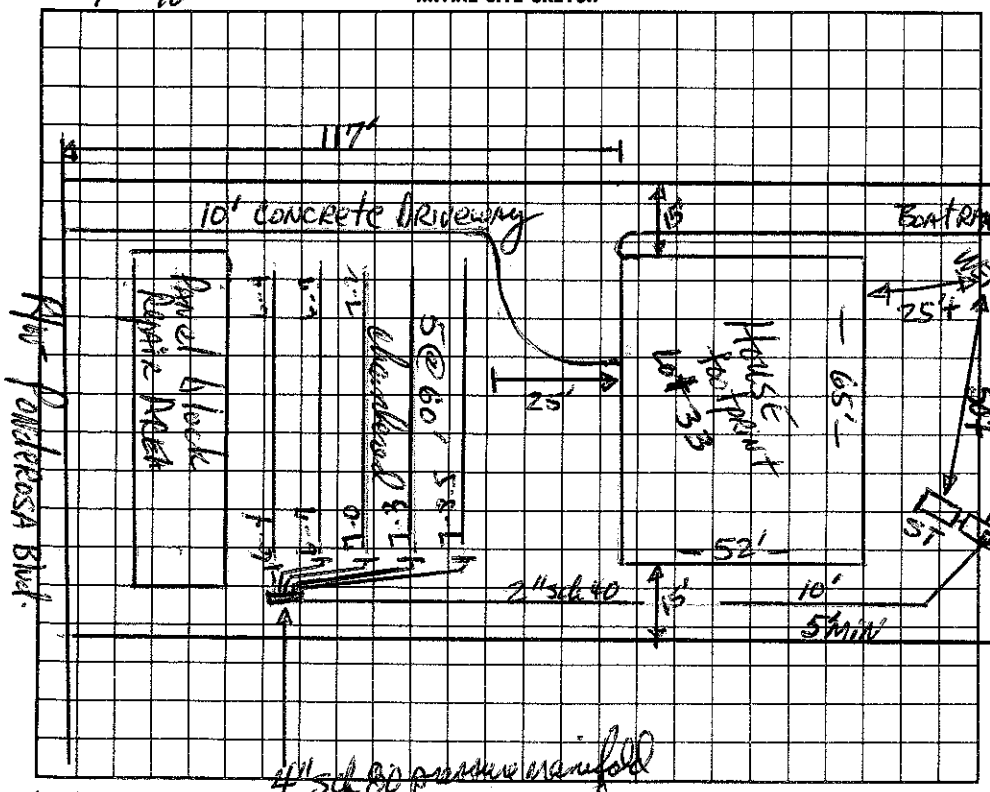

AS BUILT SKETCH

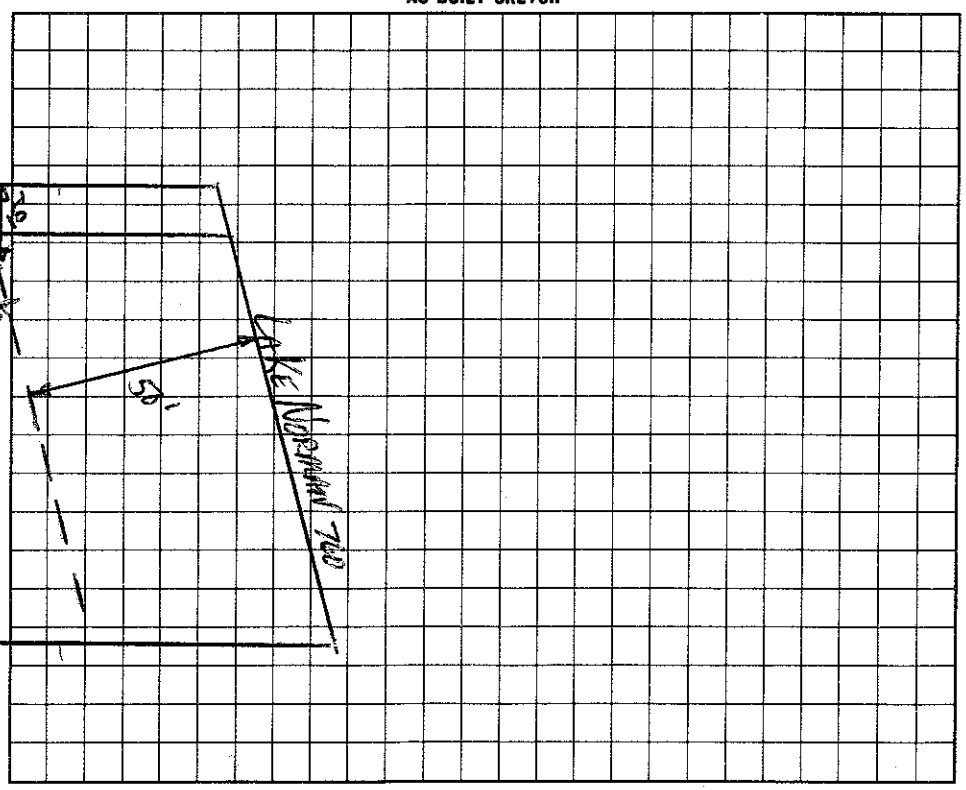

I understand that this permit can be suspended or revoked if any false information is supplied toward securing the permit/any unauthorized changes are made to the site/any unauthorized changes are made in the installation of the system.

Signed: Rosemary Dixon

Improvement Permit by: [signature] date 5-7-96

Existing System Inspection by: [signature] date 5-7-96

Installed by: Bob Mayhew

Certificate of Completion by: date

Operation Permit by: Wesley Sparks R.S. date 1/8/97

HEALTH DEPT. COPY: WHITE INSPECTION COPY (FINAL): GREEN OWNER COPY (FINAL): YELLOW INSPECTION COPY (INITIAL): PINK OWNER COPY (INITIAL): GOLD