IREDELL COUNTY HEALTH DEPARTMENT

STATESVILLE 704-878-5305 50.00 Paid MOORESVILLE 704-664-5281

IMPROVEMENT PERMIT / AUTHORIZATION TO CONSTRUCT / OPERATION PERMIT / EXISTING SYSTEM INSPECTION

PERMIT# 021780 PIN# 4646 23 7003 4646-23-6053 DATE 1/18/01

OWNER OR CONTRACTOR BOB ZARNOCH PHONE: Business 309-0682 Home (704) 664-3254

ADDRESS 614 WOODBERRY DR. MOORESVILLE NC 28115

LOCATION WILLIAMSON RD., ® PONDEROSA, B/F GRAVEL ON ®

SUBDIVISION BONANZA BLOCK / SECTION ____ LOT 35 LOT AREA .54 Ac. SITE CLASS. PS DESIGN FLOW 360 L.T.A.R. .3

Septic Tank: 1000 Gallons; STB 794 Date 12/5/00
Pump Tank: 1000 Gallons; PT 27 Date ____
Pump Make: ZOELLER Model N-152 Serial No. ____
Nitrification Field: No Fields 1 Square Feet 1200 Linear Feet 400
No Lines 5 Trench Width 3' Max Trench Bottom Depth 36" Gravel Depth N/A

☑ New System ☐ Repair System Type: I, II, III, IV, V, VI
System Description: PUMP/PM/ 25% REDUCTION
Repair System Description: N/A, DEED RECORDED 9/F 1983
Maintenance Agreement Required: ☐ Yes ☑ No


☑ House/Mod. Home No. Bedrooms 4
☐ Mobile Home No. Bathrooms 3.5
☐ Business No. Employees ____
☐ Other ____
☐ Slab ☑ Crawl Space ☑ Basement w/plumbing ☐ Basement wo/plumbing

Water Supply: ☑ Individual ☐ Public ☐ Community

Comments:/Conditions: New Tank Location noted. AWS

Comments:/Conditions: 11/30/01 Based on measurements and probings the driveway addition is too close to drainfield. There is a risk of sewage following the utility ditches and backing below the drainfield area. This should be monitored if system is placed in continuous use.

INITIAL SITE SKETCH 1"=60'

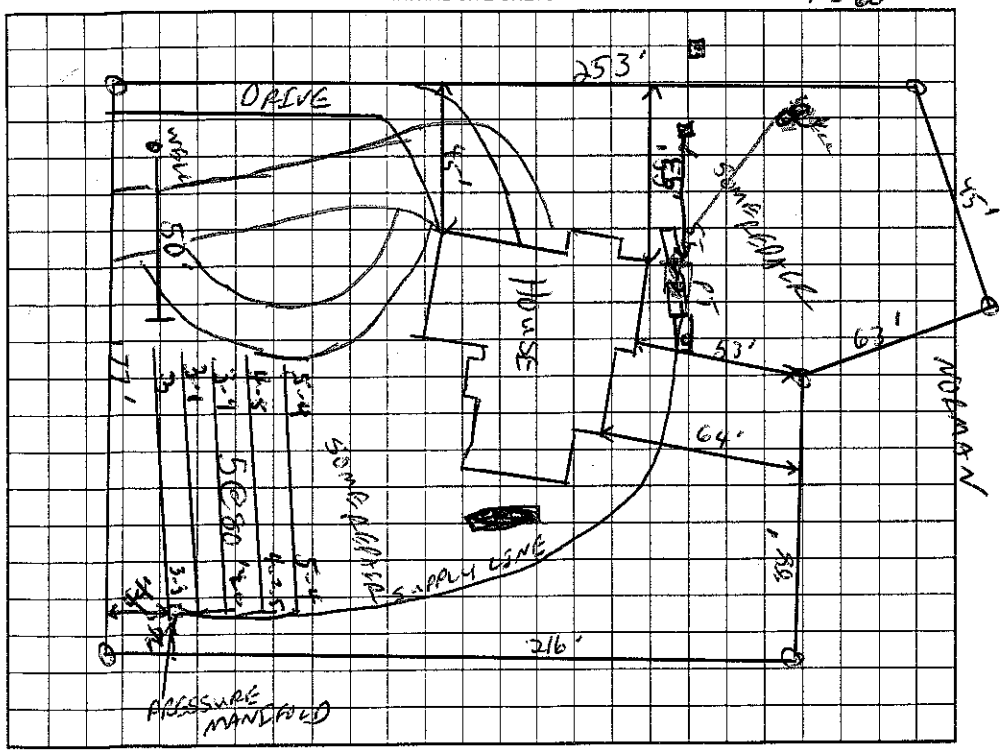

AS BUILT SKETCH

Permit can be suspended or revoked if any false information is supplied toward securing the permit/any unauthorized changes are made to the site/any unauthorized changes are made in the installation of the system. Improvement Permit with plat valid without expiration. Improvement Permit with site plan valid for sixty months. Authorization to Construct is valid for a period equal to that of Improvement Permit – not to exceed sixty months.

Signed: ____ date 1-18-01 Installed by: Buddy Chaney

Improvement Permit by: C. B. Zarnoch RS date 1/18/01 Operation Permit by: Wesley Sparks RS. date 11/30/01

Authorization to Construct by: C. B. Zarnoch RS date 1/18/01 Existing System Inspection by: ____ date ____

HEALTH DEPT. COPY: WHITE OWNER COPY (FINAL): YELLOW OWNER COPY (INITIAL): PINK